


*Barton*

**KANSAS**

Section 25 Township 17 Range 11-W

Well Number 4 McLean

Company Republic O & G

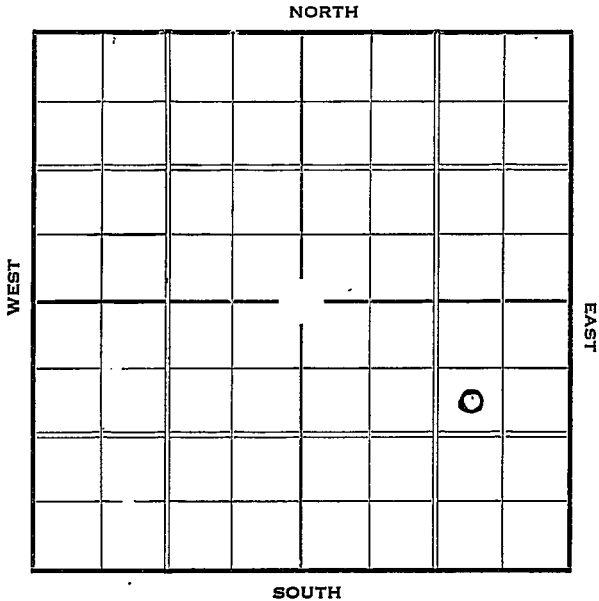

Barton

Form 252-A-5M-7-36-Palace

KANSAS

Sec. 25 Twp. 17 R. 11W

Well No. 4 McLean Farm


Republic Oil & Gas Company

990 Ft. from N. Line

Ft. from S. Line

990 Ft. from E. Line

Ft. from W. Line

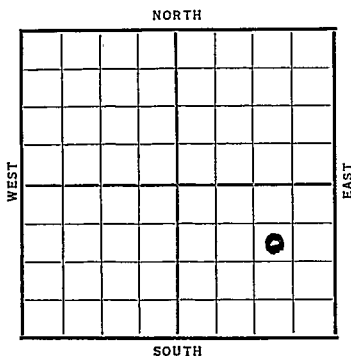

Date	REPORT
1937	
1/6	Rigging up
1/14	10" @ 172'. T. D. 180'. WOC.
1/21	Drlg. 2394'.
1/28	Sil. 3286' RUST.
2/4	6" @ 3286 T.D.3310'
2/10	Sil. 3286'.
	T. D. 3310'.
	Potential 1934 natural.
	<b>COMPLETED</b>

# KANSAS

Map No. 55 Sec. 25 Twp. 17 R. 11W

Well No. 4 McLean

Republic Oil & G. Company

Contractor

## SECTION PLAT

			o

990 Ft. from N. Line

\_\_\_\_\_ Ft. from S. Line

990 Ft. from E. Line

\_\_\_\_\_ Ft. from W. Line

## FIRST REPORT

Location \_\_\_\_\_

Rig up \_\_\_\_\_

Drilling and Remarks:

*Rigging up*

## RECORD

Cased \_\_\_\_\_ in., \_\_\_\_\_ ft.

Sand \_\_\_\_\_

Gas \_\_\_\_\_

Oil \_\_\_\_\_

Total Depth \_\_\_\_\_

## PRODUCTION

1st 24 hrs. Nat. \_\_\_\_\_

1st 24 hrs. after shot \_\_\_\_\_

Gas \_\_\_\_\_ Cu. Ft.

Dry Hole \_\_\_\_\_

Abandoned \_\_\_\_\_

Date

JAN 6 1937 19

S. J. LEWIS Scout

# KANSAS

Map No. \_\_\_\_\_ Sec. 25 Twp. 17 R. 11W

Well No. 4 Mc Sean

Republic Oil Co. Company

\_\_\_\_\_  
Contractor

### SECTION PLAT

			0

990 Ft. from N. Line

\_\_\_\_\_ Ft. from S. Line

990 Ft. from E. Line

\_\_\_\_\_ Ft. from W. Line

## COMPLETED

Location \_\_\_\_\_

Rig up \_\_\_\_\_

Drilling and Remarks:

*Oil 3286*

*Potential*

*1934 natural*

### RECORD

Cased \_\_\_\_\_ in., \_\_\_\_\_ ft.

Sand \_\_\_\_\_

Gas \_\_\_\_\_

Oil \_\_\_\_\_

Total Depth 3310

### PRODUCTION

1st 24 hrs. Nat. \_\_\_\_\_

1st 24 hrs. after shot \_\_\_\_\_

Gas \_\_\_\_\_ Cu. Ft.

Dry Hole \_\_\_\_\_

Abandoned \_\_\_\_\_

Date  
FEB 10 1937

S. J. LEWIS Scout