

KANAS


Barton


Form 51-5M-4-36-Palace

Section 25 Township 17 Range 11-W

Well Number #4-Moran

Company Texas

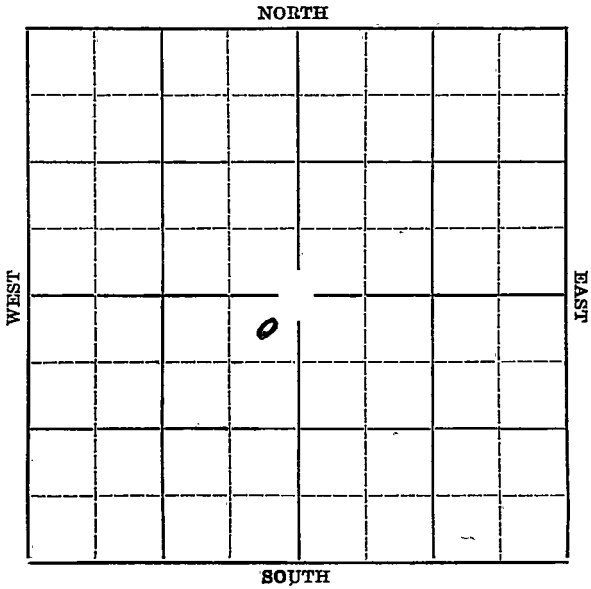

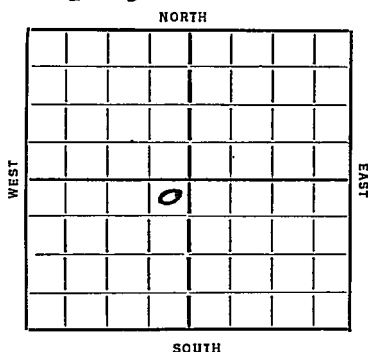Map No. KANSAS Sec. 25 Twp. 17 R. 11WWell No. #4 Moran FarmThe Texas Company. Company330' Ft. from N. Line Ft. from S. Line330' Ft. from E. Line Ft. from W. Line*lev. 1824*Date
1936

REPORT

8/5 Location8/13-- 8/20-- 8/27-- 9/3-- 9/10-- 9/18--9/24-- 10/1-- 10/8-- 10/15-- 10/22-- 10/29--11/6-- 11/12-- 11/19-- 11/27-- 12/3--12/10-- KZXX12/17 Rig.12/24 Rig & Tools.12/29 Drlg. 200'.19371/7 12" @ 181'. Drlg. 2580'.1/14 Drlg. 3205'.1/21 Sil. 3277' Set 7". RUST.1/28 RUST.2/4 T.D. 3300' Swabbed 300 bbls 10hrs2/10 Sil. 3277'. T. D. 3300'. 2000 acid. Potential 1349.**COMPLETED**

KANSAS

Form 26-1M Bks. 2-29

Map No. 55 Sec. 25 Twp. 17 R. 11WWell No. 4 MoranTexas Company

Contractor

SECTION PLAT

	0		

830 Ft. from N. Line

_____ Ft. from S. Line

330 Ft. from E. Line

_____ Ft. from W. Line

FIRST REPORT

Location ✓

Rig up _____

Drilling and Remarks:

RECORD

Cased _____ in., _____ ft.

Sand _____

Gas _____

Oil _____

Total Depth _____

PRODUCTION

1st 24 hrs. Nat. _____

1st 24 hrs. after shot _____

Gas _____ Cu. Ft.

Dry Hole _____

Abandoned _____

Date

AUG 5 1936

19

S. J. LEWIS Scout

KANSAS

Map No. _____ Sec. 25 Twp. 17 R. 11W

Well No. 4 Moran

Texas Company

Contractor

SECTION PLAT

330 Ft. from N. Line

_____ Ft. from S. Line

330 Ft. from E. Line

_____ Ft. from W. Line

	0		

COMPLETED

Location _____

Rig up _____

Drilling and Remarks:

Sil 3277

2000 aciol

Potential

1349

RECORD

Cased _____ in., _____ ft.

Sand _____

Gas _____

Oil _____

Total Depth 3300

PRODUCTION

1st 24 hrs. Nat. _____

1st 24 hrs. after shot _____

Gas _____ Cu. Ft.

Dry Hole _____

Abandoned _____

Date

FEB 10 1937 19

S. J. LEWIS Scout