


KANSAS

Section 11 Township 12 Range 16WWell No. 3 OswaldCompany C. L. Roberts

Blue Hill NORTH

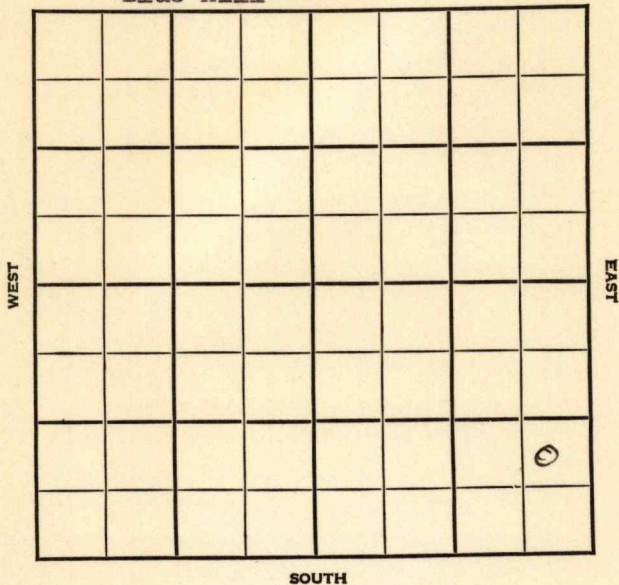

KANSAS

Ellis


Sec. 11 Twp. 12 R. 16-W

Well No. #3 Oswald Farm

C. L. Roberts Company

Blue Hill Pool

NORTH

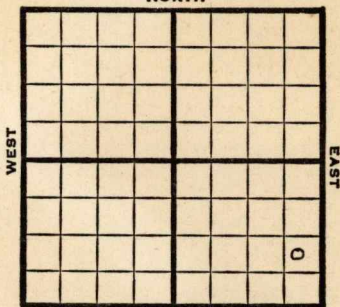

SOUTH

Ft. from N. Line

990' Ft. from S. Line

430' Ft. from E. Line

Ft. from W. Line

NE SE SE

1947

Elev. 1862' REPORT

11/12 Location

11/19 "

11/25 "

12/3 Spud

12/10 8" @ 717'

Lansing 3076'

Drlg. 3165'

12/30 Lans. 3076'

Arb. 3364'

5" @ 3364'

Perf. Liner

TD 3426'

ABANDONED

Kansas

Map No. _____ Sec. 11 Twp. 12 R. 16WWell No. 3 Oswald_____
C. L. Roberts Company_____
FIRST REPORT Contractor

NE SE SE

SECTION PLAT

Ft. from N. Line990 Ft. from S. Line430 Ft. from E. Line_____
Ft. from W. Line

			0

Ellis CountyLocation X

Rig up _____

Drilling and Remarks:

RECORD

Cased _____ in., _____ ft.

Sand _____

Gas _____

Oil _____

Total Depth _____

PRODUCTION

1st 24 hrs. Nat. _____

1st 24 hrs. after shot _____

Gas _____ Cu. Ft.

Dry Hole _____

Abandoned _____

Date

NOV 12 1947 19S. J. LEWIS Scout

