

Section 25 Township 17 Range 11W

Well No. 5 McClellan

Company Texas Company

NORTH

					0		

WEST

EAST

SOUTH

Barton KANSAS ✓

Sec. 25 Twp. 17 R. 11 W

Well No. # 5 McClean Farm

Texas Company Company

Anschutz Drlg. Contractor


Ft. from N. Line

990 Ft. from S. Line

Ft. from E. Line

990 Ft. from W. Line

NE SW NE

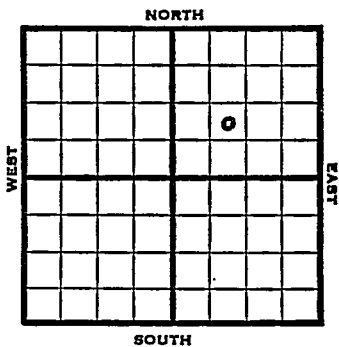

1952

REPORT

12/10

Spud 12-8-52
Drlg. 624'

12/11

Ø624

12/18

Ø2911

12/23

Spud 12-8-52
D & A TD 3332' 10" @ 622
Heeb 2888' Br. lime 3003' Lans. 3018
Arb. 3326'
DST 3327-32 open 1 hr. rec 10' oil,
660' SW 980#
TD 3332' D & A

ABANDONED

County **Barton** State **Kansas**

Sec. **25** (Blk. Twp.) **17** (Sur. Rge.) **11W** Map No.

Operator **Texas Company**

Well No. **5** Farm **McGlean**

Elev. Location **NE SW NE**

			0		
FIRST REPORT					

990 Ft. From **S** Line **NE**

990 Ft. From **W** Line **Quarter**

Ist. Report **DEC 10 1952**

Completion

Remarks

Anschutz Drlg. - Contr.

Spudding Date **12-8-52**

Drlg. Data

drlg. 624

