


Section 25 Township 17 Range 11-W

Well Number 6 McLean

Company Republic Nat. Gas

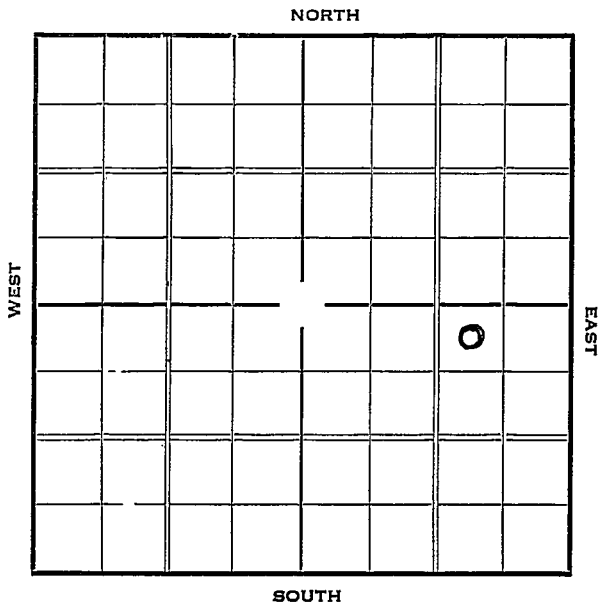

Sec. 25 Twp. 17 R. 11-W

Well No. #6 McLean Farm

Republic Nat. Gas. Company


330 Ft. from N. Line

 Ft. from S. Line

990 Ft. from E. Line

 Ft. from W. Line

Elev. 1833

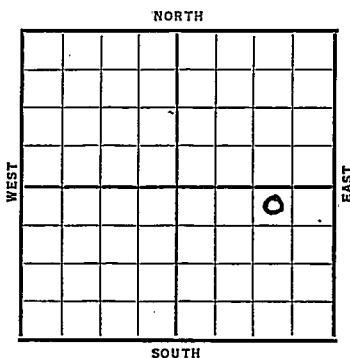

Date	REPORT
1937	
4/7	Location
4/16	Rig
4/23	10" @ 175'. WOC.
4/30	Drlg. 1951'.
5/7	Drlg. 3072'.
5/14	Sil. 3278'. T.D. 3285'.
	7" @ 3278'. RUST.
5/21	T.D. 3292'.
	Pumped 1281 Natural.
	1000 acid.
5/26	7" @ 3278'.
	Sil. 3278'.
	T.D. 3292'.
	1000 acid.
	Pot. 1564 bbls.
	COMPLETED

KANSAS *Barton*

Map No. _____ Sec. 25 Twp. 17 R. 11W

Well No. 6 McLean

Republic Nat. Gas Company

Contractor

SECTION PLAT

			0

320 Ft. from N. Line

_____ Ft. from S. Line

990 Ft. from E. Line

_____ Ft. from W. Line

FIRST REPORT

Location ✓

Rig up _____

Drilling and Remarks:

RECORD

Cased _____ in., _____ ft.

Sand _____

Gas _____

Oil _____

Total Depth _____

PRODUCTION

1st 24 hrs. Nat. _____

1st 24 hrs. after shot. _____

Gas _____ Cu. Ft.

Dry Hole. _____

Abandoned _____

Date

APR 7 1937 19

S. J. LEWIS Scout

Barton KANSASMap No. _____ Sec. 25 Twp. 17 R. 11 ^WWell No. 6-mcLeanRepublic Natural Company

Contractor

COMPLETED

SECTION PLAT

			0

330 Ft. from N. Line

_____ Ft. from S. Line

990 Ft. from E. Line

_____ Ft. from W. Line

Location _____

Rig up _____

Drilling and Remarks:

1000 AcidPat - 1564

RECORD

Cased 7 in., 3278 ft.~~Sand~~ Sil 3278

Gas _____

Oil _____

Total Depth 3292

PRODUCTION

1st 24 hrs. Nat. _____

1st 24 hrs. after shot _____

Gas _____ Cu. Ft.

Dry Hole _____

Abandoned _____

Date

H. D. Hatfield

MAY 26 1937 19

Scout