


Section 25 Township 17 Range 11-W

Well Number 6 Moran

Company Texas

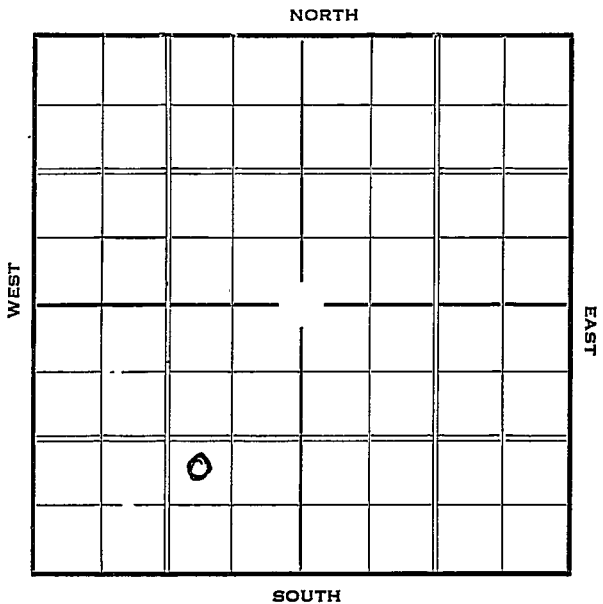

KANSAS*Barton*Map No. _____ Sec. 25 Twp. 17 R. 11WWell No. 6 MoranTexas.

Company _____

Contractor _____

SECTION PLAT

	0		

_____ Ft. from N. Line

990 Ft. from S. Line990 Ft. from E. Line

_____ Ft. from W. Line

FIRST REPORT

Location _____

Rig up _____

Drilling and Remarks:

10" @ 214 WOC**RECORD**

Cased _____ in., _____ ft.

Sand _____

Gas _____

Oil _____

Total Depth _____

PRODUCTION

1st 24 hrs. Nat. _____

1st 24 hrs. after shot _____

Gas _____ Cu. Ft.

Dry Hole _____

Abandoned _____

Date

APR 7 1937 19S. J. LEWIS

Scout

Barton KANSAS

Map No. 55 Sec. 25 Twp. 17 R. 11WWell No. 6-MoranTexas Company

Contractor

COMPLETED**SECTION PLAT**

	0		

_____ Ft. from N. Line

990 Ft. from S. Line990 Ft. from E. Line

_____ Ft. from W. Line

Location _____

Rig up _____

Drilling and Remarks:

1000 APOT 1373C**RECORD**

Cased _____ in., _____ ft.

Sand 511 3289

Gas _____

Oil _____

Total Depth 3303**PRODUCTION**

1st 24 hrs. Nat. _____

1st 24 hrs. after shot _____

Gas _____ Cu. Ft.

Dry Hole _____

Abandoned _____

Date

MAY 5 - 1937 19H. H. Hatfield Scout