

Barton


KANSAS

Form 51-5M 5-37 Petrol

Section 25 Township 17 Range 11-W

Well No. 7 - Moran

Company Texas

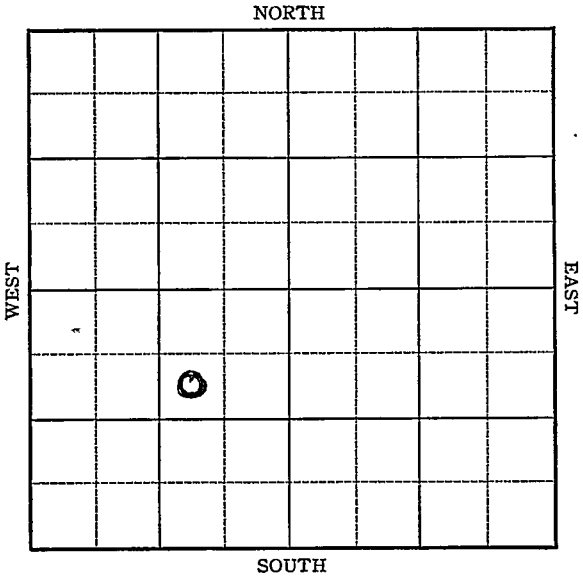



*Barton* KANSAS

Map No. 55 Sec. 25 Twp. 17 R. 11W

Well No. 7-Moran

Texas Company

Contractor

### FIRST REPORT

### SECTION PLAT

990 Ft. from N. Line

\_\_\_\_\_ Ft. from S. Line

990 Ft. from E. Line

\_\_\_\_\_ Ft. from W. Line

	o		

Location \_\_\_\_\_

Rig up \_\_\_\_\_

Drilling and Remarks:

*10" 295*

*Dlg 2960*

### RECORD

Cased \_\_\_\_\_ in., \_\_\_\_\_ ft.

Sand \_\_\_\_\_

Gas \_\_\_\_\_

Oil \_\_\_\_\_

Total Depth \_\_\_\_\_

### PRODUCTION

1st 24 hrs. Nat. \_\_\_\_\_

1st 24 hrs. after shot \_\_\_\_\_

Gas \_\_\_\_\_ Cu. Ft.

Dry Hole \_\_\_\_\_

Abandoned \_\_\_\_\_

Date

**JUN 2 1937** 19

**H. D. Hatfield** Scout

Map No. 55 Sec. 25 Twp. 17 R. 11 WWell No. 7-MoranTexas Company

Contractor

**COMPLETED****SECTION PLAT**990 Ft. from N. Line     Ft. from S. Line990 Ft. from E. Line     Ft. from W. Line

	0		

Location \_\_\_\_\_

Rig up \_\_\_\_\_

Drilling and Remarks:

1000 AcidPat 482**RECORD**Cased 7 in., 3314 ft.Sand 511 3313

Gas \_\_\_\_\_

Oil \_\_\_\_\_

Total Depth 3317**PRODUCTION**

1st 24 hrs. Nat. \_\_\_\_\_

1st 24 hrs.-after shot \_\_\_\_\_

Gas \_\_\_\_\_ Cu. Ft.

Dry Hole \_\_\_\_\_

Abandoned \_\_\_\_\_

Date

JUN 16 1937 19H. D. Hatfield Scout