

Ellis

Form 51-5M-11-38-Palace


KANSAS

Section 11 Township 12 Range 16-W

Well No. 12 Oswald "B" (Twin #5)

Company J. J. Hall

NORTH Blue Hill Pool

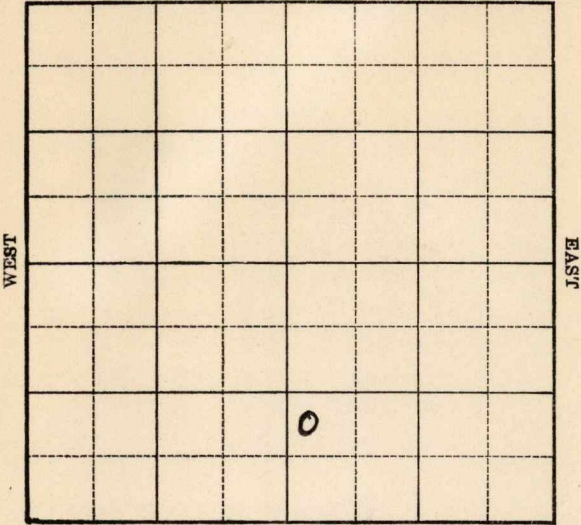

SOUTH

Sec. 11 Twp. 12 R. 16-W

Well No. #12 Oswald "B" (Twin #5) Farm

J. J. Hall Company


(Blue Hill)

_____ Ft. from N. Line

990 Ft. from S. Line

_____ Ft. from E. Line

280 Ft. from W. Line

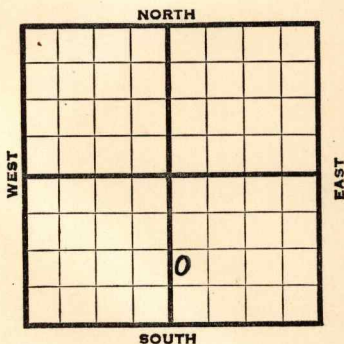

1939	REPORT
1/18	15" - 508' . 12" - 684' . Anhy. 1020' . 10" - 1026' . Drlg. 1045' .
1/27	Drlg. 2150' .
2/3	8" - 2545' . T. D. 2640' U. R.
2/10	" " " " " "
2/17	5" - 2770' Topeka 2808' . S.O. 2808-15 Dlg. 2820
2/23	5" cement 2809' Drlg. 2895' .
3/3	" " " " "
3/8	5" - 2809' . Topeka 2808' . T. D. 3030' . 6000 acid. Pump 151 bbls. 8 hrs. Potential 452 bbls.
	COMPLETED

Ellis

KANSAS

Map No. 71 Sec. 11 Twp. 12 R. 16W

Well No. 12 Oswald "B" (Twin #5)

J. J. Hall

Company

Contractor

FIRST REPORT

NW SW SE

_____ Ft. from N. Line

990 Ft. from S. Line

_____ Ft. from E. Line

280 Ft. from W. Line

BLUE HILL POOL

SECTION PLAT

		0	

Location _____

Rig up _____

Drilling and Remarks:

15" - 508

12" - 684

Anhy. 1020

10" - 1026

Dr1g. 1045

RECORD

Cased _____ in., _____ ft.

Sand _____

Gas _____

Oil _____

Total Depth _____

PRODUCTION

1st 24 hrs. Nat. _____

1st 24 hrs. after shot _____

Gas _____ Cu. Ft.

Dry Hole _____

Abandoned _____

Date

JAN 18 1939

19

H. D. Hatfield

Scout

Map No. 71 Sec. 11 Twp. 12 R. 16W

Well No. 12 Oswald "B" (Twin #5)

J. J. Hall Company

Contractor

COMPLETED

NW SW SE

_____ Ft. from N. Line

990 Ft. from S. Line

_____ Ft. from E. Line

280 Ft. from W. Line

Blue Hill Pool

SECTION PLAT

		0	

Location _____

Rig up _____

Drilling and Remarks:

6000 Acid

P-15 1/8

Pot 452

RECORD

Cased 5 in., 2809 ft.

Sand Topeka 2808

Gas _____

Oil _____

Total Depth 5030

PRODUCTION

1st 24 hrs. Nat. _____

1st 24 hrs. after shot _____

Gas _____ Cu. Ft.

Dry Hole _____

Abandoned _____

Date

MAR 8 - 1939 19

H. D. Hatfield Scout