


Section 11 Township 12 Range 16-W

Well No. 15 Oswald "B" (Twin to #7)

Company J. J. Hall

NORTH Blue Hill Pool

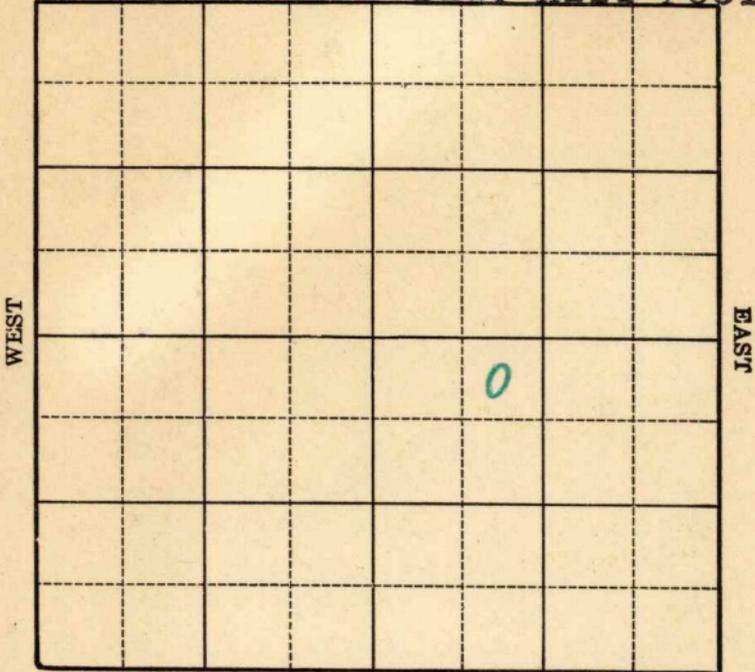

SOUTH

Sec. 11 Twp. 12 R. 16-W

Well No. #15 Oswald "B" (Twin to #7) Farm

J. J. Hall Company


(Blue Hill)

330 Ft. from N. Line

_____ Ft. from S. Line

_____ Ft. from E. Line

950 Ft. from W. Line

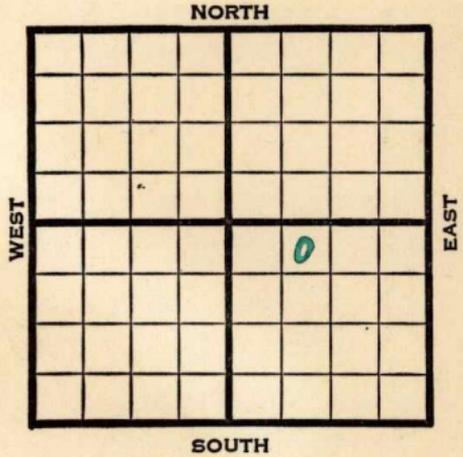

1941	REPORT
1/8	Rotary.
1/16	10" - 90' Anhy 1025' Drlg. 2440'
1/23	Lans. 3075' 5" - 3090' RUST.
1/29	Lans. 3075' 5" - 3090' T.D. 3105' 5000 acid. Depthograph potential 1592 bbls. 35. Gravity
	COMPLETED

Form 26—200 Bks.—1-40—Palace Ellis

Map No. 71 Sec. 11 Twp. 12 R. 16W

Well No. 15 Oswald "B" (Twin to #7)

J. J. Hall Company

Contractor

FIRST REPORT

SECTION PLAT

NE NW SE

330 Ft. from N. Line

Ft. from S. Line

Ft. from E. Line

950 Ft. from W. Line

		o	

BLUE HILL POOL

Location

Rig up

Drilling and Remarks: Rotary

RECORD

Cased in., ft.

Sand

Gas

Oil

Total Depth

PRODUCTION

1st 24 hrs. Nat.

1st 24 hrs. after shot

Gas Cu. Ft.

Dry Hole

Abandoned

Date

JAN 8 1941 19

S. J. LEWIS Scout

Map No. 71 Sec. 11 Twp. 12 R. 16W

Well No. 15 Oswald "B" (Twin to #7)

J. J. Hall

Company

Contractor

COMPLETED

SECTION PLAT

NE NW SE

330 Ft. from N. Line

_____ Ft. from S. Line

_____ Ft. from E. Line

950 Ft. from W. Line

BLUE HILL POOL

		o	

Location _____

Rig up _____

Drilling and Remarks:

*Loss 3075
5" @ 3096
5000 acid
Depth 281592*

35° ge

RECORD

Cased _____ in., _____ ft.

Sand _____

Gas _____

Oil _____

Total Depth 3105

PRODUCTION

1st 24 hrs. Nat. _____

1st 24 hrs. after shot _____

Gas _____ Cu. Ft.

Dry Hole _____

Abandoned _____

Date

JAN 29 1941 19

S. J. LEWIS Scout