


Section 11 Township 12 Range 16-W

Well No. ~~#2~~ Oswald (Tripple Well) #5-B

Company J. J. Hall

Blue Hill Pool

NORTH

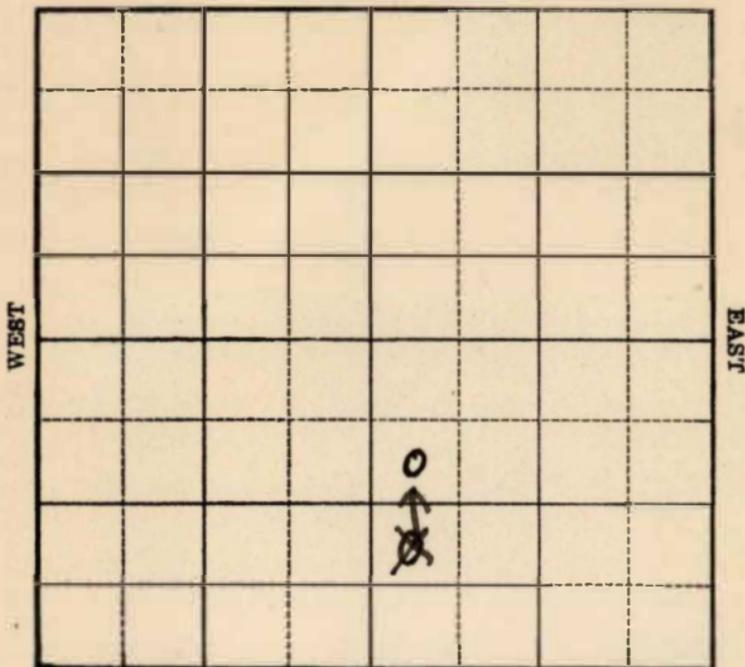

SOUTH

Sec. 11 Twp. 12 R. 16-W

Well No. ~~#2~~ Oswald (Triple Well) #5-B Farm

J. J. Hall Company


(Blue Hill)

990 Ft. from N. Line

~~960~~ Ft. from S. Line

_____ Ft. from E. Line

330
~~360~~ Ft. from W. Line

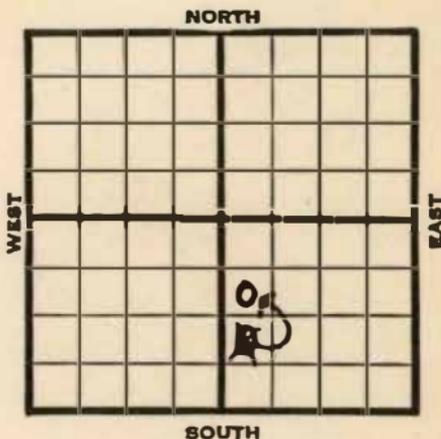

Elev. 1875

1939	REPORT
6/21	Cable rig.
6/29	" "
7/6	Rigging up.
7/13	15" - 502' 12" - 684' Drlg. 684'
7/20	10" - 1029' Drlg. 1795'
7/27	Drlg. 2475'
8/3	8" - 2621' Drlg. 2740'
8/10	8" - 2794' Topeka 2805' S.O. 2805-11' Drlg. 2905'
8/17	TD 2905' SD.
8/24	Lans. 3075' 7" - 3078' T.D. 3106' 1000 acid. Pump 12 bbls. per hour. Shut down.
8/31	" "

OVER

1939

9/6

Lans. 3075'

7" - 3078'

T.D. 3110'

6000 acid.

Potential 1748 bbls., Pump.

COMPLETED

Map No. 71 Sec. 11 Twp. 12 R. 16W

Well No. 5 "B" Oswald

J. J. Hall Company

Contractor

COMPLETED

SW NW SE

_____ Ft. from N. Line

960 Ft. from S. Line

_____ Ft. from E. Line

350 Ft. from W. Line

BLUE HILL POOL

SECTION PLAT

		0	

Location _____

Rig up _____

Drilling and Remarks:

Log 3075

7" @ 3078.

6000 acid

Pump 1748 Pt.

RECORD

Cased _____ in., _____ ft.

Sand _____

Gas _____

Oil _____

Total Depth 3110

PRODUCTION

1st 24 hrs. Nat. _____

1st 24 hrs. after shot _____

Gas _____ Cu. Ft.

Dry Hole _____

Abandoned _____

Date

SEP 6 1939 19

S. J. LEWIS Scout

Map No. 7.1 Sec. 11 Twp. 12 R. 16W

Well No. 5 Oswald

J. J. Hall Company

CORRECTION Contractor

SECTION PLAT

SW NW SE

990 Ft. from N. Line

_____ Ft. from S. Line

_____ Ft. from E. Line

330 Ft. from W. Line

		10	

BLUE HILL POOL

Location _____

Rig up _____

Drilling and Remarks:

Reported:

NW SW SE

and No 2.

RECORD

Cased _____ in., _____ ft.

Sand _____

Gas _____

Oil _____

Total Depth _____

PRODUCTION

1st 24 hrs. Nat. _____

1st 24 hrs. after shot _____

Gas _____ Cu. Ft.

Dry Hole _____

Abandoned _____

Date

JUL 19 1939 19

S. J. LEWIS


Scout

Sam - Our map shows a ± 5 comp. well
 in NW cor SW SE Sec 11 - 12S - 16W.
 Please have scout check the
 well no. on this ticket.

High Pathways

DESCRIPTION

SECTION PLAT

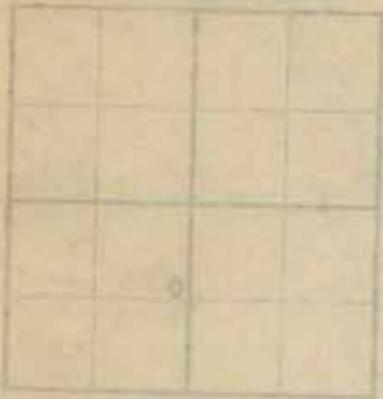

330
 Pt from W. line
 Pt from E. line
 Pt from S. line
 Pt from N. line

BLUE HILL POOL

RECORD

Location
 Rise up
 Fall line and Remarks
 Cause
 Band
 in

Reported:

- Misc Small Maps ~~Ray~~
- Cards ~~Ray~~
- Tracing ~~Ray~~
- France Map ~~Ray~~
- Scarborough Map ~~Ray~~
- Moody Map
- Geological Dept.
- Moody Flat Book

Ellis

KANSAS

Sec. 11 Twp. 12 R. 16W

Well No. 2 Oswald (Triple well)

J. J. Hall

Company

Contractor

CORRECTION

NW SW SE

Ft. from N. Line

960 Ft. from S. Line

Ft. from E. Line

350 Ft. from W. Line

BLUE HILL POOL

SECTION PLAT

		o	

Location

Rig up

Drilling and Remarks:

Cable Rig

RECORD

Cased in., ft.

Sand

Gas

Oil

Total Depth

PRODUCTION

1st 24 hrs. Nat.

1st 24 hrs. after shot

Gas Cu. Ft.

Dry Hole

Abandoned

Date

JUN 28 1939

19

S. J. LEWIS

Scout

Ellis

KANSAS

Map No. 71 Sec. 11 Twp. 12 R. 16W

Well No. 5-B Oswald

J. J. Hall Company

CORRECTION Contractor

SW NW SE

990 Ft. from N. Line

_____ Ft. from S. Line

_____ Ft. from E. Line

330 Ft. from W. Line

SECTION PLAT

Location _____

Rig up _____

Drilling and Remarks:

Reported as:

NW SW SE and as
#2

RECORD

Cased _____ in., _____ ft.

Sand _____

Gas _____

Oil _____

Total Depth _____

PRODUCTION

1st 24 hrs. Nat. _____

1st 24 hrs. after shot _____

Gas _____ Cu. Ft.

Dry Hole _____

Abandoned _____

Date

JUL 26 1939

19

S. J. LEWIS

Scout

Map No. _____ Sec. 11 Twp. 12 R. 16W

Well No. 2 Oswald

J. J. Hall

Company _____

Contractor _____

FIRST REPORT

NW SW SE

_____ Ft. from N. Line

990 Ft. from S. Line

_____ Ft. from E. Line

320 Ft. from W. Line

BLUE HILL POOL

SECTION PLAT

Location _____

Rig up _____

Drilling and Remarks: _____

Cable Rig _____

Cased _____ RECORD
Sand _____ in., _____ ft.

Gas _____

Oil _____

al Depth _____

PRODU _____

1st 24 hr. Nat _____ CTION

1st 24 hrs. after _____

Gas _____ shot _____

Dry Hole _____ Cu. Ft.

Abandoned _____

Date _____

JUN 21 1939

S. J. LEWIS

Scout

KANSAS

We show #5 Oswald "B" here. Same feet measurements. Don Schriener

County

Location

SECTION PLAT

RECORD

- Misc. Small *Map*
- Cards *Map*
- Tracing Map *Map*

