


Section 25 Township 17 Range 11-W

Well Number 7 - McLean

Company National Ref.

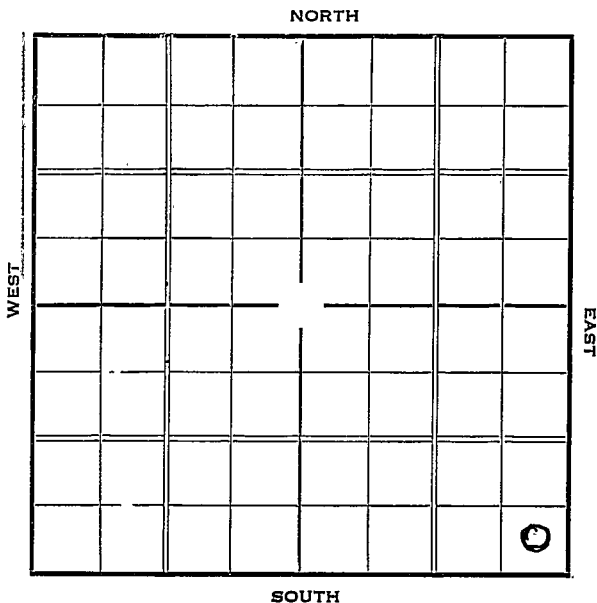

Sec. 25 Twp. 17 R. 11-W

Well No. #7 McLean Farm


National Ref. Company

_____ Ft. from N. Line

330 Ft. from S. Line

330 Ft. from E. Line

_____ Ft. from W. Line

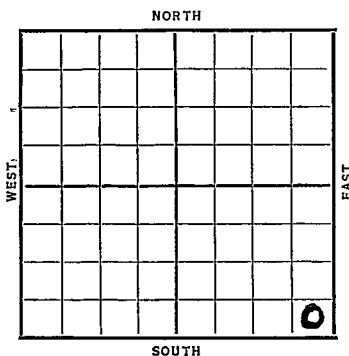

Date

REPORT

1937

6/23 Mat. on Gr.

7/2 " "

7/9 " "

7/16 " "

7/23 " "

7/30 " "

8/6 B. R.

8/13 Rig.

8/20 12" @ 244'. Drlg. 360'.

8/28 Anhy 599'1 Drlg. 1045'.

9/3 Drlg. 1850'.

9/10 8" @ 2350'. Drlg. 2500'.

9/17 K.C. 2990'? Drlg. 3015'.

9/24 7" @ 3109'. Drlg. 3240'.

10/2 Sil. & 7" @ 3284'. WOC.

No shows reported.

OVER

1937

10/6

7" @ 3284'.

Sil. 3284'.

T.D. 3305'.

Pump 191 bbls. 4 hrs & 209 bbls
4 hours.

Potential 1184 bbls. Nat.

COMPLETED

Barton KANSAS

Map No. 55 Sec. 25 Twp. 17 R. 11 W

Well No. 7 - McLean

National Ref Company
 Contractor

FIRST REPORT

SECTION PLAT

_____ Ft. from N. Line

330 Ft. from S. Line

330 Ft. from E. Line

_____ Ft. from W. Line

			①

Location _____

Rig up _____

Drilling and Remarks:

Mat. on gr

RECORD

Cased _____ in., _____ ft.

Sand _____

Gas _____

Oil _____

Total Depth _____

PRODUCTION

1st 24 hrs. Nat. _____

1st 24 hrs. after shot _____

Gas _____ Cu. Ft.

Dry Hole _____

Abandoned _____

Date

JUN 23 1937 19

H. D. Hatfield Scout

Barton KANSAS

Map No. _____ Sec. 25 Twp. 17 R. 11WWell No. 7 McLean

_____ National Refg _____ Company

_____ Contractor

COMPLETED

SE/C

_____ Ft. from N. Line

330 Ft. from S. Line330 Ft. from E. Line

_____ Ft. from W. Line

SECTION PLAT

			0

Location _____

Rig up _____

Drilling and Remarks:

P-19 1/4 & 20 9/4

POT-1184

NAT

RECORDCased 7 in., 3284 ft.Sand 511 3284

Gas _____

Oil _____

Total Depth 3305**PRODUCTION**

1st 24 hrs. Nat. _____

1st 24 hrs. after shot _____

Gas _____ Cu. Ft.

Dry Hole _____

Abandoned _____

Date

337 - 6 1937 19

H. D. Hatfield

Scout