

KANSAS

Section 26 Township 17 Range 11WWell No. 1 BloomerCompany Eldorado Ref.

Bloomer Pool

NORTH

							0

WEST

EAST

SOUTH

KANSAS

Barton

Sec. 26 Twp. 17 R. 11W ✓

Well No. #1 Bloomer Farm

Eldorado Ref. Company

Bloomer


990' Ft. from N. Line

 Ft. from S. Line

330' Ft. from E. Line

 Ft. from W. Line

SE NE NE

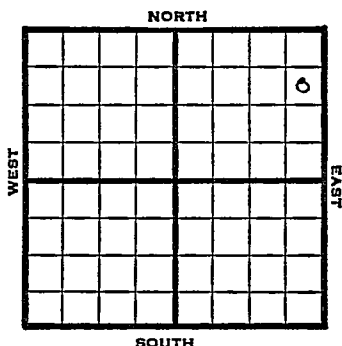

1948

Eli 1839'

REPORT

10/27

RUR

11/3

8" @ 300'

Drlg. 1000'

11/10

Lansing 3015'

Drlg. 3061'

11/16

Arbuckle 3295'

TD 3306'

5" @ 3297'

11/23

"

11/30

500 acid

Swb 5 bbls oil / 1 W 5 hrs

12/8

TD 3334'

Arb. 3295'

Aband.

ABANDONED

Map No. _____ Sec. 26 Twp. 17 R. 11W

Well No. 1 Bloomer

Eldorado Ref. _____ Company

FIRST REPORT _____ Contractor

SE NE NE


SECTION PLAT

990 Ft. from N. Line

_____ Ft. from S. Line

330 Ft. from E. Line

_____ Ft. from W. Line

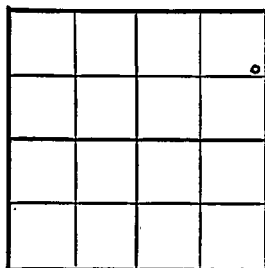

Barton County

Location _____

Rig up _____

Drilling and Remarks:

R U R

RECORD

Cased _____ in., _____ ft.

Sand _____

Gas _____

Oil _____

Total Depth _____

PRODUCTION

1st 24 hrs. Nat. _____

1st 24 hrs. after shot _____

Gas _____ Cu. Ft.

Dry Hole _____

Abandoned _____

Date

OCT 27 1948

19

S. J. LEWIS

Scout

Kansas

Bloomer Pool

Map No. 55 Sec. 26 Twp. 17 R. 11WWell No. 1 Bloomer


Eldorado Ref.

Company

ABANDONED

Contractor

SE NE NE

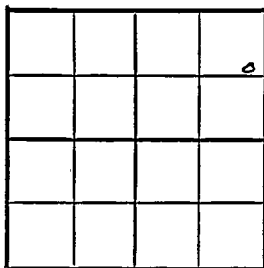E1. 1889
SECTION PLAT990 Ft. from N. Line Ft. from S. Line330 Ft. from E. Line Ft. from W. Line

Barton County

Location

Rig up

Drilling and Remarks:

Cr 8295

RECORD

Cased in., ft.Sand Gas Oil Total Depth 3295

PRODUCTION

1st 24 hrs. Nat. 1st 24 hrs. after shot Gas Cu. Ft.Dry Hole Abandoned

Date

DEC 8 1948 19

Scout