FORM 51 10M 7-48 PETROL

KANSAS


Barton

Section 26 Township 17 Range 11W

Well No. 1 Geimenhardt

Company Forney & Williams

Wildcat

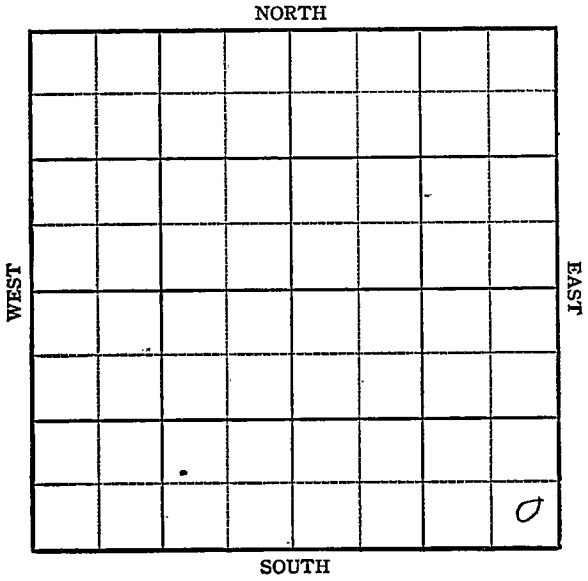

FORM 252-A;
5M 4-48 PETROL

KANSAS Barton ✓

Sec. 26 Twp. 17 R. 11W

Well No. 1 Geimenhardt Farm

Forney & Williams Company

Wildcat


____ Ft. from N. Line

330 Ft. from S. Line

330 Ft. from E. Line

____ Ft. from W. Line

SE/C.

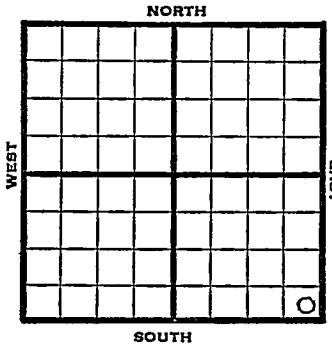

1948	Eli 1816' REPORT
8/25	8" @ 182' Drlg 2650'
9/1	Lansing 3015' Cong 3290' Arb. 3314' TD 3344' Aband.

ABANDONED

Form 27—100 Bks.—4-48—Petrol

Barton County Kansas State

Map No. Sec. 26 Twp. 17 R. 11W


Well No. 1 Geimenhardt

Forney & Williams Company

FIRST REPORT Contractor

SE/C

SECTION PLAT

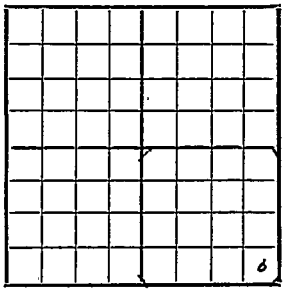

Ft. from N. Line

330 Ft. from S. Line

330 Ft. from E. Line

Ft. from W. Line

Wildcat

Remarks:

8" @ 182 drlg. 2650

Date AUG 25 1948

Scout S. J. LEWIS

Form 27—100 Bks.—4-48—Petrol

Barton County Kansas State

Map No. [illegible] Sec. 26 Twp. 17 R. 11W

Well No. 1 Geimenhardt


Forney & Williams Company

ABANDONED Contractor

SE/C

E. 1876

SECTION PLAT

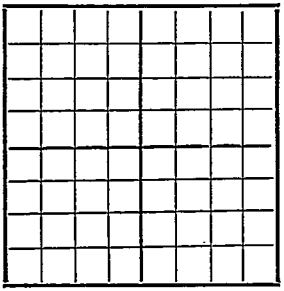

Ft. from N. Line

330 Ft. from S. Line

330 Ft. from E. Line

Ft. from W. Line

Wildcat


Remarks:

Conv 3015

Conf 3290

Ark 3314

DT D3344

 

Date SEP 1 1948

Scout S. J. LEWIS