

State Kansas County LeFlore

Company Repp- Ferguson Oil Well No. 1


Farm Robin

Survey

Block No. Sec. 26 Twp. 29^W Range 18^W

Co-Ord. Elev.

C. Sec Sec

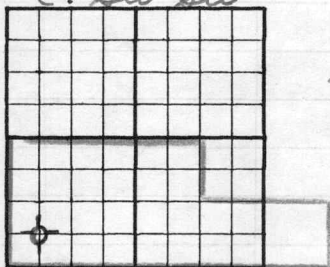

M. R. Royalty
Newman

4950' Miss Test

NOTE: Show Sketch of Lease and Well Location in Above Space

Ft. from N. Line

Ft. from S. Line

Ft. from W. Line

Ft. from E. Line

Date	Depth	
<u>4-26-61</u>		<u>(3:15 p.m.) Spud</u>
		<u>8 5/8" @ 309' w/175 spm.</u>
		<u>P.D. @ 12:45 a.m. 4/27/61</u>
		<u>Cement circulated</u>
	<u>4897</u>	<u>Miss. (-2738)</u>
<u>D. S. 2 #1 -</u>	<u>4903 - 20 - of 30" Rev.</u>	
		<u>25' mud B.H.P. ^(30") -1210-365 #</u>
		<u>mb. bl.</u>
	<u>4965</u>	<u>R. J. D.</u>