


Section 12 Township 12 Range 16 W

Well No. # 1 Dreiling 'C' - 1000

Company Salina Drlg.

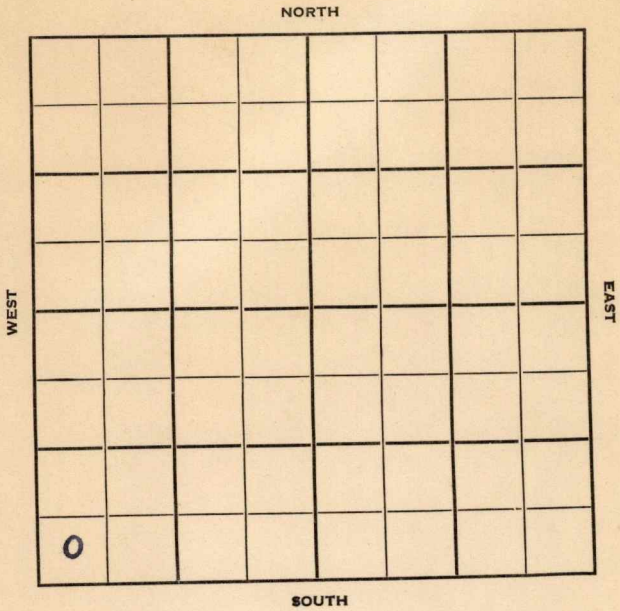

Sec. 12 Twp. 12 R. 16W

Well No. #1 Dreiling 'C' - 11000 Farm

Salina Drlg. Company

Salina Drlg. Contractor


Ft. from N. Line

330 Ft. from S. Line

Ft. from E. Line

330 Ft. from W. Line

SW SW SW

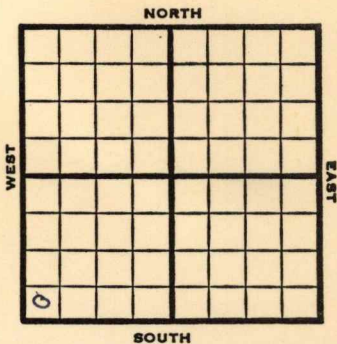

1952 Elev. 1843' REPORT

11/18	Spud 11-8-52 8" @ 115' Anhy 1000' Top. 2737 Drlg. 2935'
11/27	Heeb 2999', Dodge 3012, Lans 3049', Arb 3326 RTD 335 7" @ 3327'
12/4	NR
12/11	NR
12/18	NR
12/25	NR
1/1	CO 3335
1/8	NR
1/23	Spud 11-8-52 Oil Well TD 3335 8" @ 115' Anhy 1000, Top 2737, Heeb 2999, Dodge 3012, Lans 3049, Arb. 3326 TD 3335 7" @ 3327, CO to 3335, 1000A Comp. 50 bopd

COMPLETED

