


Section 13 Township 12 Range 16-W

Well No. #2 Dreiling (A)

Company Leo Drilling

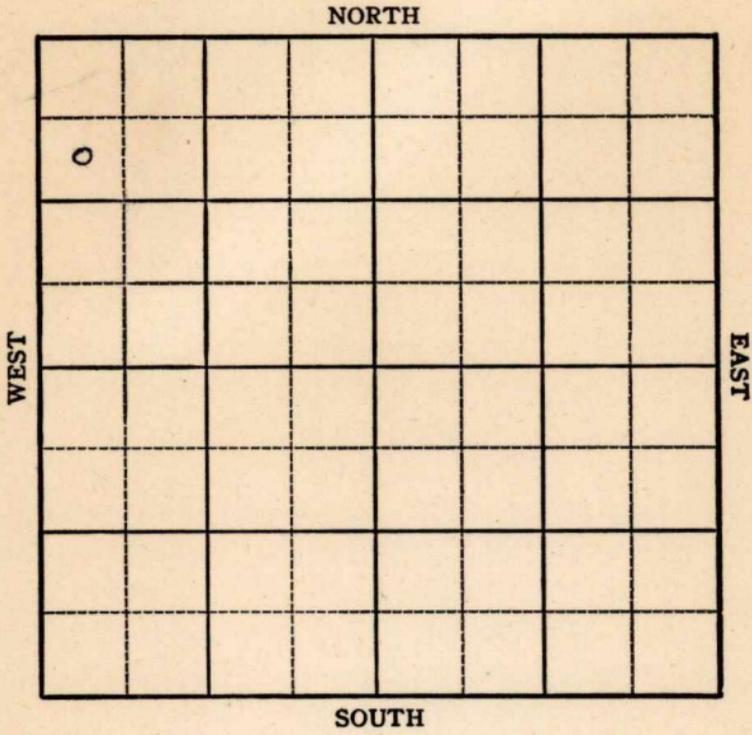

Ellis

KANSAS

Sec. 13 Twp. 12 R. 16W ✓

Well No. #2 Dreiling (A) Farm

Leo Dreiling Company

Kiowa Drlg. Contractor

Blue Hill


990' Ft. from N. Line

\_\_\_\_\_ Ft. from S. Line

\_\_\_\_\_ Ft. from E. Line

330' Ft. from W. Line

SW NW NW

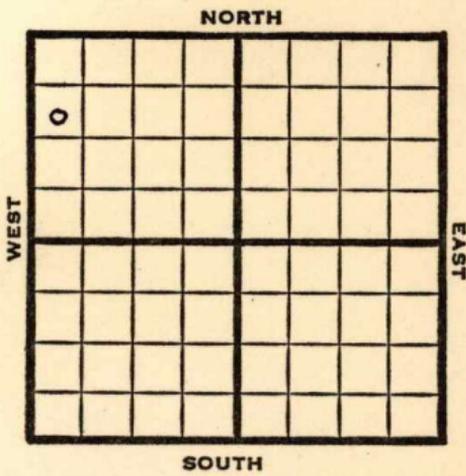

1950

Elev 1814

REPORT

5/17

Spud 5-2-50  
 8" @ 700'  
 Anhy 950'  
 Hub 2976'  
 So. 3056-58  
 So. 3090-94  
 DST 3081-95 opn 20 min  
 Rec. mud  
 Drlg. 3305'

7/19

8" @ 700  
 Anhy 950 Heeb 2976  
 Lans 3026  
 SO 3056-58  
 SO 3090-94  
 DST 3081-95, opn 20 min rec mud  
 Arb 3313  
 TD 3316  
 5" @ 3314  
 DD 3317  
 500 acid  
 DD 3324  
 500 acid  
 DD 3370  
 4" limer @ 3370  
 TD 3373  
 SP 3103, 24/3056-68, Comp 70 bopd 3% wtr  
 Completed

COMPLETED

Map No. \_\_\_\_\_ Sec. 13 Twp. 12 R. 16<sup>W</sup>

Well No. 2 Dreiling (A)

Leo Dreiling \_\_\_\_\_ Company

Kiowa Drlg. \_\_\_\_\_ Contractor

SW NW NW

SECTION PLAT

990 Ft. from N. Line

\_\_\_\_\_ Ft. from S. Line

\_\_\_\_\_ Ft. from E. Line

330 Ft. from W. Line

0			
FIRST REPORT			

Ellis

Location \_\_\_\_\_

Rig up \_\_\_\_\_

Drilling and Remarks:

Spud 5-2-50

8" @ 700

Anhy. 950

Hub. 2976

Lans. 3026

So. 3056-58

So 3090-94

DST 3081-95 open 20

Min. Rec. mud.

Date

Drlg. 3305

RECORD

Cased \_\_\_\_\_ in., \_\_\_\_\_ ft.

Sand \_\_\_\_\_

Gas \_\_\_\_\_

Oil \_\_\_\_\_

Total Depth \_\_\_\_\_

PRODUCTION

1st 24 hrs. Nat. \_\_\_\_\_

1st 24 hrs. after shot \_\_\_\_\_

Gas \_\_\_\_\_ Cu. Ft.

Dry Hole \_\_\_\_\_

Abandoned \_\_\_\_\_

MAY 17 1950

19

J. E. TYRA Scout

Kansas

Map No. \_\_\_\_\_ Sec. 13 Twp. 12 R. 16W

Well No. 2 Dreiling "A"

Leo Dreiling Company

Contractor

SW NW NW

E1. 1814  
SECTION PLAT

990 Ft. from N. Line

\_\_\_\_\_ Ft. from S. Line

\_\_\_\_\_ Ft. from E. Line

330 Ft. from W. Line

0			

COMPLETE

Ellis County

Location \_\_\_\_\_

Rig up \_\_\_\_\_

Drilling and Remarks:

8" @ 700

Anhy 950

Heeb. 2976

Lans. 3026

SO 3056-58

SO 3090-94

DST 3081-95

RECORD

Cased \_\_\_\_\_ in., \_\_\_\_\_ ft.

Sand \_\_\_\_\_

Gas \_\_\_\_\_

Oil \_\_\_\_\_

Total Depth 3373

PRODUCTION

1st 24 hrs. Nat. \_\_\_\_\_

1st 24 hrs. after shot \_\_\_\_\_

Gas \_\_\_\_\_ Cu. Ft.

Dry Hole \_\_\_\_\_

Abandoned \_\_\_\_\_

Date

**JUL 19 1950** 19

J. E. TYRA Scout

Open 20 min.

Rec. mud

Arb. 3313

TD 3316

5" @ 3314

DD 3317

500 acid

DD 3324

500 acid

DD 3370

4" liner @ 3370

TD 3373

SP 3103

24/ 3056-68

Comp. 70 bopd 3% water

Misc.

Pierce Map

France Map

Tracings

Land Wall Map

Land Small Map

Scout Cards

m t

AUG 1 1950


SECTION 1814  
ET. 1814

Contractor:  
Company:




