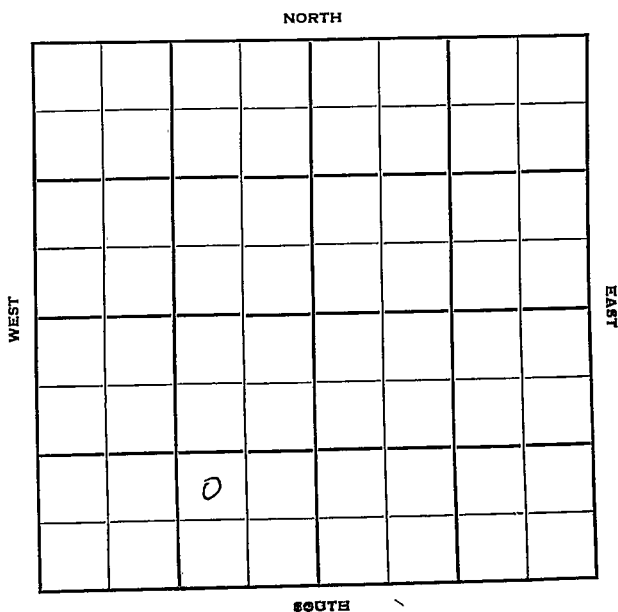


Section 26 Township 17 Range 11WWell No. #2 Norris "A"Company Florney & Williams

KANSAS

Barton

Sec. 26 Twp. 17 R. 11-W

Well No. #2 Norris "A" Farm

Florney & Williams Company

Flourney & Williams Contr. Contractor

Kraft-Prusa Pool


 Ft. from N. Line

990 Ft. from S. Line

990 Ft. from E. Line

 Ft. from W. Line

NW SE SW

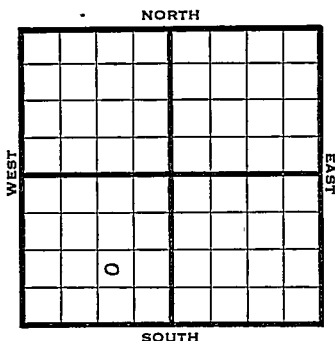

1950 Elev 1845

REPORT

8/30 Spud 8-24-50
8" @ 204
drilg 2045

10/11 Spud 8-24-50
Oil Well TD 3316'
8" @ 204 TD 2295
Skid 10' east 8" @ 210
Anhy 655' Heeb. 2899'
Br Lime 3007' Lans. 3021'
DST 3160-66 opn 1 hr rec. 10' socm
Cong. 3292' Arb. 3310-16
DST 3309-16 opn 1 hr Rec. 330' oil
60' ocm tr. wtr 5" @ 3310
TD 3316 S/1 boph 500 A
S/4 bfph 18% wtr.
270 bopd 19% wtr.

COMPLETED

Operator **Florney & Williams**

Well No. 2 Farm Norris "A"

Elev. 1845 Location NW SE SW

0

990 Ft. From S Line SW

990 Ft. From **E** Line Quarter

1st. Report AUG 30 1950

Completion

Remarks

Spudding Date 8-24-50

Drig. Data Kraft-Prusa Pool

8th @ 204 drlg. 2045

J. E. TYRA

