


Section 26 Township 17 Range 11-W

Well No. #2 Staatz

Company Elourney & Williams

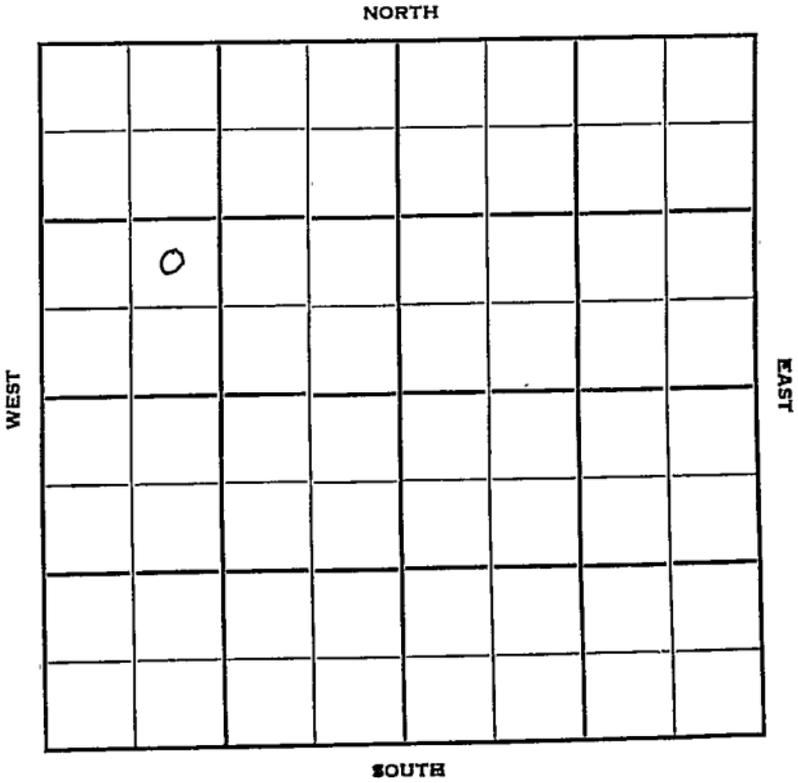

Sec. 26 Twp. 17 R. 11-W

Well No. #2 Staatz Farm

Flourney & Williams Company

Kraft-Prusa Contractor


 Ft. from N. Line

990 Ft. from S. Line

 Ft. from E. Line

990 Ft. from W. Line

NE SW NW

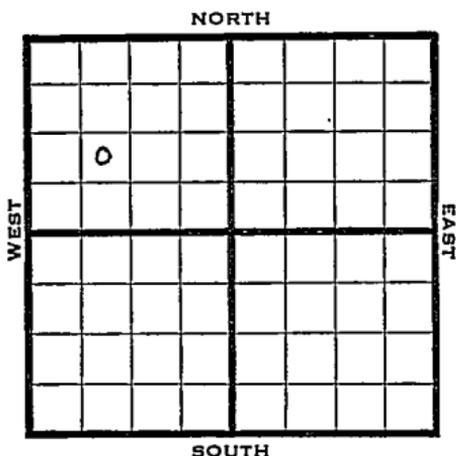

1950 Elev 1847

REPORT

7/19 Spud 7-10-50
8" @ 203

Anhy 603-40

Drlg 2960

8/30 8" @ 203

Anhy 603-40 Heeb 2893

Br lime 2999 Lans 3011

Cong 3282 Arb 3303

5" @ 3304

TD 3311

Comp 140 bopd

Completed

COMPLETED

Kansas

Kraft-Prusa

Map No. _____ Sec. 26 Twp. 17 R. 11W

Well No. 2 Staatz

Flourney & Williams

Company

Contractor

NE SW NW


SECTION PLAT

_____ Ft. from N. Line

990 Ft. from S. Line

_____ Ft. from E. Line

990 Ft. from W. Line

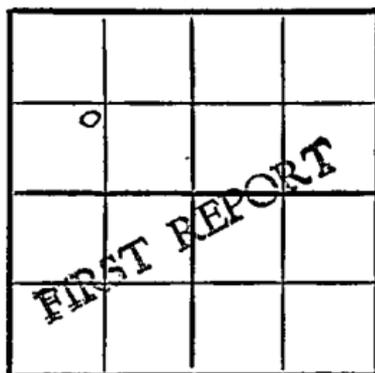

Barton County

Location _____

Rig up _____

Drilling and Remarks:

Spud 7-10-50

8" @ 203

Anhy 603-40

drlg. 2960

RECORD

Cased _____ in., _____ ft.

Sand _____

Gas _____

Oil _____

Total Depth _____

PRODUCTION

1st 24 hrs. Nat. _____

1st 24 hrs. after shot _____

Gas _____ Cu. Ft.

Dry Hole _____

Abandoned _____

Date

JUL 19 1950

19

J. E. TYRA

Scout

