

Ellis

KANSAS

SECTION 13 TOWNSHIP 12 RANGE 16 W

WELL NO. #6 Dreiling "A"

COMPANY Leo. J. Dreiling

NORTH

	0						

WEST

EAST

SOUTH

Ellis

KANSAS

SEC.	TWP.	R.
13	12	16W

WELL NO. #6 Dreiling "A" FARM

COMPANY Leo J. Dreiling

CONTRACTOR Sidey


Blue Hill

\_\_\_\_\_ Ft. from N. Line

\_\_\_\_\_ Ft. from S. Line

\_\_\_\_\_ Ft. from E. Line

\_\_\_\_\_ Ft. from W. Line

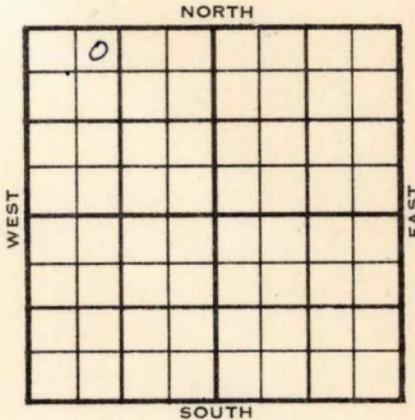

NE NW NW

	ELEVATION	REPORT
1956	1827	
1-11	Comm. 12-8-55 8" @ WOC	
3/28	Comm 12-8-55 Anh 960 h 2990 L 3039 A 3327 TD 3331 8 5/8" @ 95/75 5 1/2" @ 3330 DD 3350 2000 A DP to 3340 500 A S/4 boph Comp 35 bopd	
		<b>COMPLETED</b>

County Ellis Elev. \_\_\_\_\_  
 Sec. 13 Twp. 12 Rge. 16W  
 Company Leo J. Dreiling  
 Farm Name Dreiling "A" No. 6

Co.

TOPS	DEPTH	LOG	DATUM
Anh.			
Tp.			
H.			
Tr.			
Dg.			
Bl.			
L.			
K.C.			
B.K.C.			
Ce.			
C.			
M.			
M.			
K.			
Mz.			
Mq.			
V.			
S.			
S.			
A			
R.			
Pe.			
G.			
T.D.			

Loc. in Sec. NE NW NW

Geol. \_\_\_\_\_  
 Contr. Sidey

Pool Blue Hill

FIRST REPORT  
 JAN 11 '56

Lse.


No.

Sec.

T.

R.

Date Comm. 12-8-55  
8" @ WOC

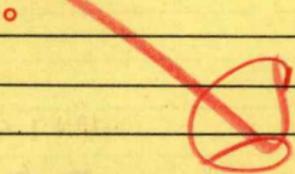

County Ellis Elev. 1827  
 Sec. 13 Twp. 12 Rge. 16W  
 Company Leo J. Dreiling  
 Farm Name Dreiling "A" No. 6

TOPS	DEPTH	LOG	DATUM	Loc. in Sec.	
Anh.	<u>960</u>			<u>NE NW NW</u>	
TP.	
H.	<u>2990</u>	
Tr.	
Dg.	
Bl.	
L.	<u>3039</u>		<u>1212</u>	Geol.	
K.C.				Contr.	
B.K.C.				<u>Sidey</u>	
Ce.				Pool	
C.				<u>Blue Hill</u>	
M.				<table border="1"> <tr> <td></td> <td></td> <td></td> <td></td> </tr> </table>	
M.	
K.	
Mz.	
Mq.	
V.	
S.	
S.	
A.	<u>3327</u>		<u>1500</u>	<b>COMPLETE</b>	
R.	
PE.	
G.	
TD.	<u>3331</u>	

Date Comm. 12-8-55  
8 5/8" @ 95/75 5 1/2" @ 3330 DD 3350  
2000 A DP to 3340 500 A  
S/4 boph Comp. 35 bopd

Co.  
Lse.  
No.  
Sec.  
T.  
R.