

Ellis

KANSAS

SECTION 22 TOWNSHIP 12 RANGE 16 W

WELL NO. #1 Glinther 'A'-1000

COMPANY Mast Drlg.

NORTH

WEST

EAST

						0	

SOUTH

Ellis

KANSAS

SEC.	TWP.	R.
22	12	16W

WELL NO.

#1 Giinther 'A' - 1000

FARM

COMPANY

Mast Drlg

CONTRACTOR

Co. Tools


NE Emmeram

_____ Ft. from N. Line

_____ Ft. from S. Line

_____ Ft. from E. Line

_____ Ft. from W. Line

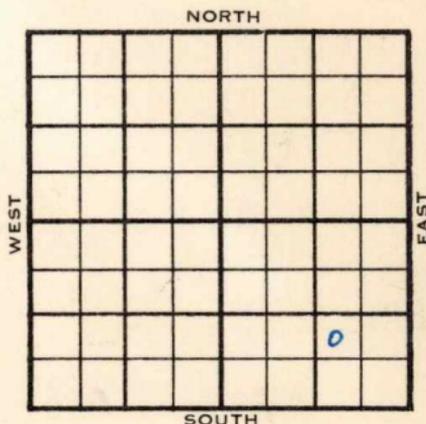

NW SE SE

GSO - FO


1955	ELEVATION	REPORT
	1934	
10/19	Comm 10-13-55 8" @ 243 Drlg 2550	
12-14	DST 3165-76 op 1 hr. rec 570' oil, 40' ocm, 50' m&w, 490/20" DST 3236-45 op 1 hr. gas in 50 min. rec. 600' oil, 540/20" 5½" @ 3409 CO to 3413, 500 A S/ 2 boph, 1500 A 5½ boph, Comp. 55 BOPD Anh. 1084 H. 3056 Dodge 3116 L. 3144 A. 3409 TD 3413'	

COMPLETED

County Ellis Elev. _____
 Sec. 22 Twp. 12 Rge. 16W
 Company Mast Drlg.
 Farm Name Glinther 'A1' - 1000 No. 1

TOPS	DEPTH	LOG	DATUM	Loc. in Sec.
Anh.				NW SE SE
Tr.				
Dg.				
Bl.				
L.				Geol. _____
K.C.				Contr. _____
B.K.C.				Co. tools
Ce.				
C.				Pool
M.				
M.				NE Emeram
K.				
Mz.				<div style="border: 1px dashed black; padding: 5px; text-align: center;"> <p>FIRST REPORT</p> <p>OCT 19 1955</p> </div>
Me.				
V.				
S.				
S.				
A.				
R.				
Pe.				
G.				
T.D.				

Date Comm. 10-13-55 CSO - FO
8" @ 243 drlg. 2550

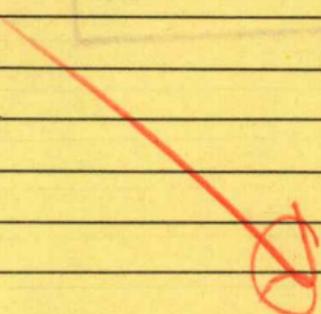


Co.
Lse.
No.
Sec.
T.
R.

County Ellis Elev. 1934
 Sec. 22 Twp. 12 Rge. 16W
 Company Mast Drlg.
 Farm Name Giinther 'A'-1000 No. 1

TOPS	DEPTH	LOG	DATUM
Anh.	1084		
Tp.			
H.	3055		1121
Tr. <u>Dodg q.</u>	3116		1182
Dg.			
B.L.			
L.	3144		1210
K.C.			
B.K.C.			
Ce.			
C.			
M.			
M.			
K.			
Mz.			
Mq.			
V.			
S.			
S.			
A.	3409		1475
R.			
Pe.			
G.			
T.D.	3413		

Loc. in Sec. NW SE SE
 Geol. _____
 Contr. _____
 Pool NE Emmeram

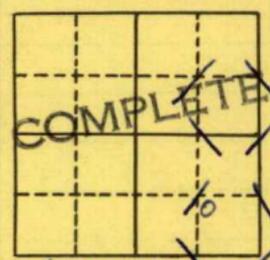

Date Comm. 10-13-55 DEC 14 1955

8" @ 243 DST 3165-76 open 1 hr.
Rec. 570' oil 40' ocm 50' m & w
490/20" DST 3236-45 open 1 hr.
gas in 50 min. rec. 600' oil 540/20"
5 1/2" @ 3409 CO to 3413 500 A
S/ 2 boph 1500 A 5 1/2 boph
Comp. 55 b opd

Co.
 Lse.
 No.
 Sec.
 T.
 R.