

KANSAS

Cowley


FORM 51 10M 7-48 PETROL

Section 29 Township 30 Range 4E

Well No. 1 Dickinson

Company C R A

Misc.
m

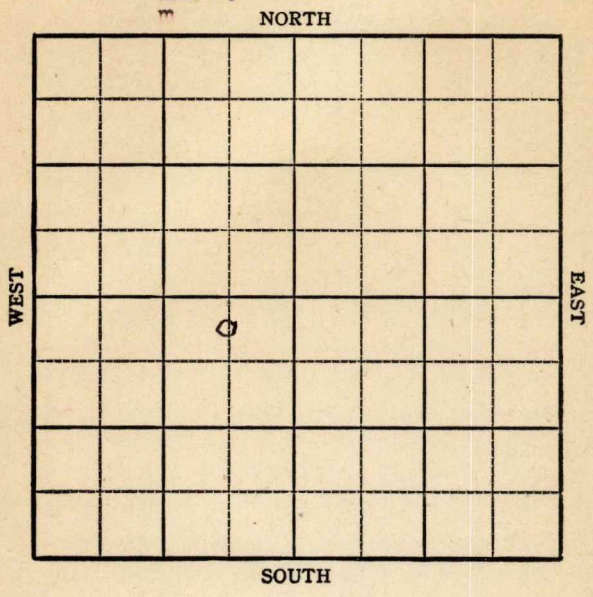

Sec. 29 Twp. 30 R. 4-E

Well No. #1 Dickinson Farm

C R A

Company

Miscellaneous


330 Ft. from N. Line

_____ Ft. from S. Line

660 Ft. from E. Line

_____ Ft. from W. Line

C N L N E S W

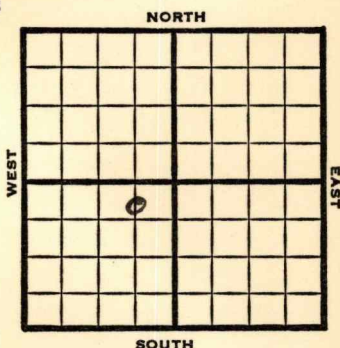

1948

Elev 1160'

REPORT

12/8

RUR

12/14

8" @ 84'

Drlg 1856'

12/22

Bart 2811'

TD 2817'

5" @ 2814'

12/29

"

1/5 ¹⁹⁴⁹

"

1/12

TD 2827

Swb & 1 bbls oil PH 12 hrs.

1/19

20 qts 2815-24

1/26

Swb 5 bbls oil PH

2/2

"

2/9

Swb 5 bbls oil PH

2/16

"

2/23

TD 2827'

Bart 2811'

5" @ 2814'

Pump 50 oil Pot

39° Gr.

Comp

COMPLETED

Kansas

Miscellaneous

Map No. K11 Sec. 29 Twp. 30 R. 4E

Well No. 1 Dickinson

C R A etal. Company

COMPLETE Contractor

C N L NE SW

E41160
SECTION PLAT

330 Ft. from N. Line

_____ Ft. from S. Line

660 Ft. from E. Line

_____ Ft. from W. Line

	o		

Cowley County

Location _____

Rig up _____

Drilling and Remarks:

Bar Y2571

5" @ 2574

Pump 50 oil BT

092

RECORD

Cased _____ in., _____ ft.

Sand _____

Gas _____

Oil _____

Total Depth 2827

PRODUCTION

1st 24 hrs. Nat. _____

1st 24 hrs. after shot _____

Gas _____ Cu. Ft.

Dry Hole _____

Abandoned _____

Date

FEB 23 1949 19

S. J. LEWIS Scout

Map No. _____ Sec. 29 Twp. 30 R. 4E

Well No. 1 Dickinson

C R A

Company

FIRST REPORT

Contractor

C N L NE SW

SECTION PLAT

330 Ft. from N. Line

_____ Ft. from S. Line

660 Ft. from E. Line

_____ Ft. from W. Line

Cowley County

Location _____

Rig up _____

Drilling and Remarks:

R U R

RECORD

Cased _____ in., _____ ft.

Sand _____

Gas _____

Oil _____

Total Depth _____

PRODUCTION

1st 24 hrs. Nat. _____

1st 24 hrs. after shot _____

Gas _____ Cu. Ft.

Dry Hole _____

Abandoned _____

Date

DEC 8 1948 19

S. J. LEWIS

Scout