


Cowley

KANSAS

SECTION 4 TOWNSHIP 33 RANGE 3E

WELL NO. #1 Potts

COMPANY Frank Taylor

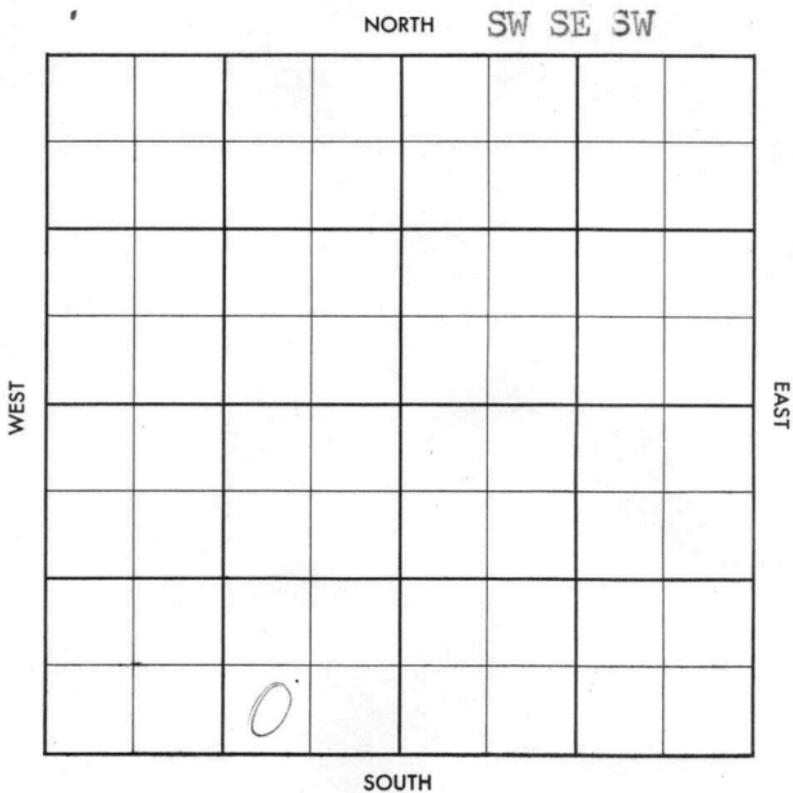

County Cowley

Elev. _____

Sec. 4

Twp. 33

Rge. 3E

Company Frank Taylor

Farm Name Potts

No. 1

TOPS	DEPTH	LOG	DATUM
Anh.			
Tr.			
H.			
Tr.			
Dg.			
B.L.			
L.			
K.C.			
B.K.C.			
Ce.			
C.			
M.			
M.			
K.			
Mz.			
Mq.			
V.			
S.			
S.			
A.			
R.			
Pf.			
G.			
T.D.			

Loc. in Sec. SW SE SW

Geol. _____

Contr. Hallmark Dr

Pool Graham

JUN 12 '57	
FIRST REPORT	
0	

Date Comm. _____

Location _____

29

Co.

Lot

No.

Sec.

T.

R.

County Cowley Elev. 1167
 Sec. 4 Twp. 33 Rge. 3E
 Company Frank Taylor
 Farm Name Potts No. 1

TOPS	DEPTH	LOG	DATUM	Loc. in Sec.
Anh.				SW SE SW
T.P.				
H. <u>Lay</u>	<u>2626</u>			
Tr.				
Dg.				
BL.				
L.				Geol.
K.C.	<u>2783</u>			Contr.
B.K.C. <u>osw</u>	<u>2971</u>			<u>Hallmark Dr</u>
Ce. <u>Bartl.</u>	<u>3174</u>			Pool
C.				<u>Graham</u>
M. <u>chat</u>	<u>3246</u>			<div style="border: 1px dashed black; padding: 5px; text-align: center;"> <p>ABANDONED</p> <p>JUL 17 '57</p> <p>o</p> </div>
M. <u>Li</u>	<u>3246</u>			
K.				
Mz.				
Ma.				
V.				
S.				
S.				
A.				
R.				
PE.				
G.				
T.D.	<u>3252</u>			

Date Comm.

Location JUN 19 '57 JUN 25 '57 MIR JUL 3 '57

6-26-57 8 5/8 110 # 2515

JUL 10 '57 JUL 17 '57 DST 2795-2811

30" 12' VSOCM BHP 40# DST

3164-86 15' Md BHP

50#

DEA