


Section 29 Township 30 Range 4E

Well No. 2 Dickinson

Company C R A

Misc. NORTH

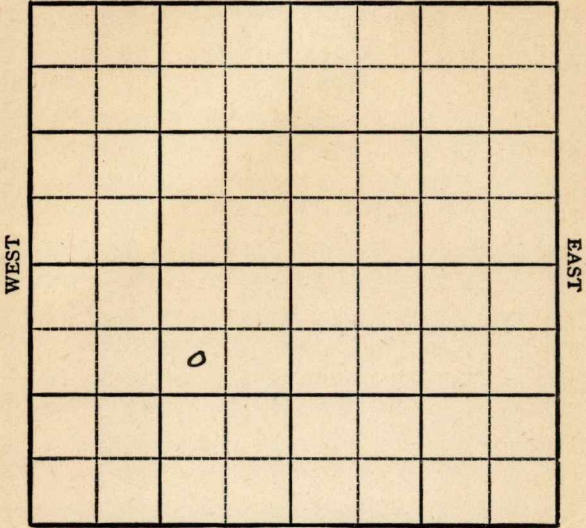

SOUTH

KANSAS

Cowley

Sec. 29 Twp. 30 R. 4E ✓

Well No. #2 Dickinson Farm

C R A

Company

Miscellaneous


990' Ft. from N. Line

 Ft. from S. Line

990' Ft. from E. Line

 Ft. from W. Line

SW NE SW

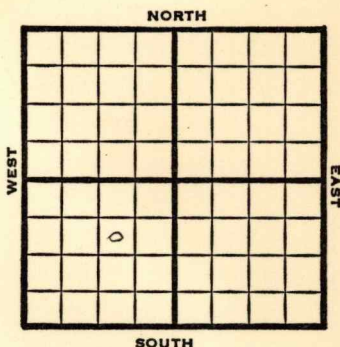

1949

Elev 1160'

R E P O R T

- 1/19 RUR
- 1/26 8"@ 82
Drlg 1350'
- 2/2 **KC 2271'**
Bart 2808'-22'
TD 2822'
5"@ 2808'
- 2/9 **KC 2271'**
Bart 2808-22'
TD 2822'
5"@ 2808'
- 2/16 TD 2837'
600' acid
- 2/23 40 qts 2816-35
CO
- 3/2 "
- 3/9 TD 2837'
Bart 2808'
5"@ 2808'
40 qts 2816-35
Pump 40 oil Pot
39° Gr.
Comp

COMPLETED

Map No. _____ Sec. 29 Twp. 30 R. 4E

Well No. 2 Dickinson

C R A

Company

FIRST REPORT

Contractor

SW NE SW

SECTION PLAT

990 Ft. from N. Line

_____ Ft. from S. Line

990 Ft. from E. Line

_____ Ft. from W. Line

Cowley County

Location _____

Rig up _____

Drilling and Remarks:

R U R

RECORD

Cased _____ in., _____ ft.

Sand _____

Gas _____

Oil _____

Total Depth _____

PRODUCTION

1st 24 hrs. Nat. _____

1st 24 hrs. after shot _____

Gas _____ Cu. Ft.

Dry Hole _____

Abandoned _____

Date

JAN 19 1949 19

S. J. LEWIS

Scout

Map No. 11 Sec. 29 Twp. 30 R. 4E

Well No. 2 Dickinson

C R A

Company

COMPLETE

Contractor

SW, NE SW

E. 1160
SECTION PLAT

990 Ft. from N. Line

_____ Ft. from S. Line

990 Ft. from E. Line

_____ Ft. from W. Line

Cowley County

Location _____

Rig up _____

Drilling and Remarks:

Bar 72508
5' 102508
409 to 2976-35
Pump 40 oil 102
29-94

RECORD

Cased _____ in., _____ ft.

Sand _____

Gas _____

Oil _____

Total Depth 2837

PRODUCTION

1st 24 hrs. Nat. _____

1st 24 hrs. after shot _____

Gas _____ Cu. Ft.

Dry Hole _____

Abandoned _____

Date

MAR 9 1949 19

S. J. LEWIS Scout