


Section 29 Township 30 Range 4E

Well No. #1 Morton

Company C R A & Shawver

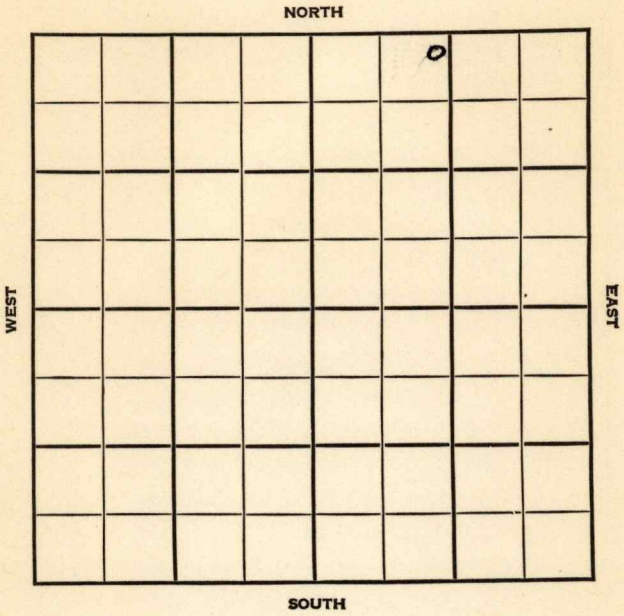

KANSAS

Cowley

30

4E

✓

Sec. 29 Twp. 30 R. 4E

Well No. #1 Morton Farm

C R A & Shawver

Company

Miscellaneous


162' Ft. from N. Line

Ft. from S. Line

1477' Ft. from E. Line

Ft. from W. Line

NE NW NE

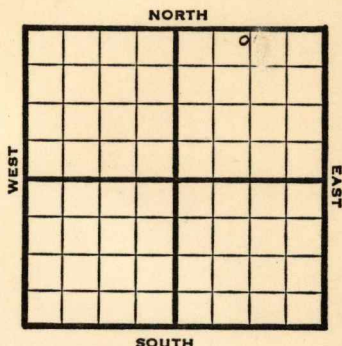

1948

Eli 1162'

REPORT

6/9 Location

6/16 8" @ 42'
Drlg. 1411'

6/23 **Part 2790'**
TD 2806'
5" @ 2795'

6/29 "

7/14 TD 2821'
Bart 2790'
5"@ 2795'
40 qts.
Pump 20 Oil Pot
38° Gr.
Comp.

COMPLETED

Map No. _____ Sec. 29 Twp. 30 R. 4E


Well No. 1 Morton

C R A & Shawver Company

FIRST REPORT Contractor

NE NW NE

SECTION PLAT

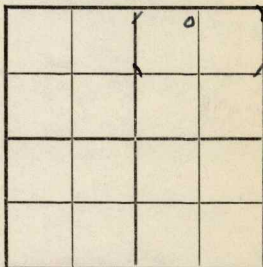

162 Ft. from N. Line

_____ Ft. from S. Line

1477 Ft. from E. Line

_____ Ft. from W. Line

Cowley County

RECORD

Location X

Cased _____ in., _____ ft.

Rig up _____

Sand _____

Drilling and Remarks:

Gas _____

Oil _____

Total Depth _____

PRODUCTION

1st 24 hrs. Nat. _____

1st 24 hrs. after shot _____

Gas _____ Cu. Ft.

Dry Hole _____

Abandoned _____

Date

JUN 9 1948

19

S. J. LEWIS

Scout

Map No. 11 Sec. 29 Twp. 30 R. 4EWell No. 1 MortonC R A & Shavver

Company

COMPLETE

Contractor

NE NW NE

E. 1162.

SECTION PLAT

162 Ft. from N. Line

Ft. from S. Line

1477 Ft. from E. Line

Ft. from W. Line

		9	

Cowley County

Location

Rig up

Drilling and Remarks:

Box 27905" 2795409 toPump 20 oil282/4

RECORD

Cased _____ in., _____ ft.

Sand _____

Gas _____

Oil ☒Total Depth 2821

PRODUCTION

1st 24 hrs. Nat. _____

1st 24 hrs. after shot _____

Gas _____ Cu. Ft.

Dry Hole _____

Abandoned _____

Date

JUL 14 1948

19

S. J. LEWIS

Scout