


Cowley

Form 51-5M-11-31-Palace

Map No. KANSAS Sec. 5 Twp. 33 R. 3E

Well No. #1 Brooks Farm
Van Meter Company

NORTH

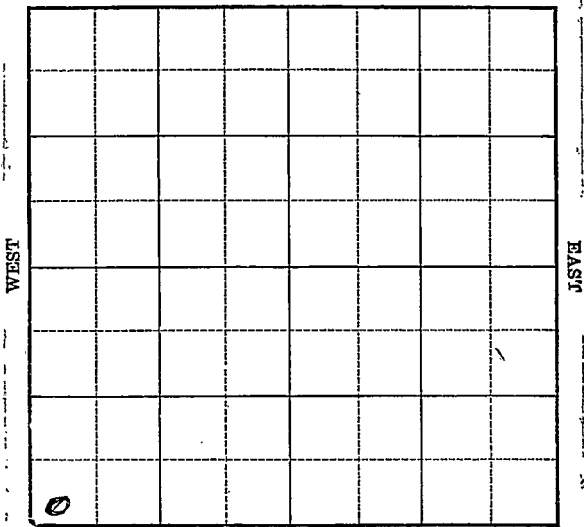

SOUTH

Location _____

Drilling Remarks _____

Rig Up Elev 1127

Drilling Remarks Le S

RECORD

Cased _____ in. _____ ft.

Sand _____

Gas _____

Oil _____

Total Depth _____

PRODUCTION

1st 24 hrs. Nat. _____

1st 24 hrs. after shot _____

Gas _____ cu. ft.

Dry Hole _____

Abandoned _____

Cowley

Map No. KANSAS Sec. 5 Twp. 33 R. 3E


Well No. #1 Brooks Farm
Van meter Company

_____ Ft. from N. Line

300 Ft. from S. Line

_____ Ft. from E. Line

300 Ft. from W. Line

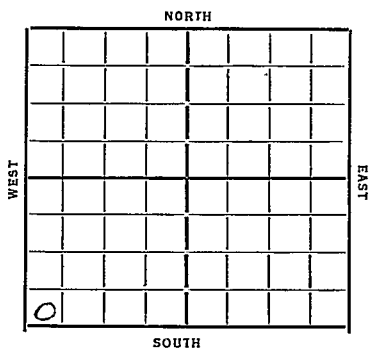

Date 1933

REPORT

9/13 R. O. G.
9/20 — 9/29 —
10/5 — 10/11 —
10/18 Drlog 500
10/25 —
11/1 S.D at 965
11/8 —
11/15 Drlog 1210
11/22 " 1887
11/29 T.D. 1965- 4R 10"
12/6 Drlog 2161
12/13 " 2525
12/27 T.D 2595- S.D
1/4 — 1/11 — 1/17 — 1/24 —
1/31 — 2/7 — 2/14 — 2/23 —
3/1 — 3/8 — 3/15 —
3/22 Drlog 3290
3/28 Siliceous 3504 7N 7 7L
3530-3575 P. F.

ABANDONED

Cowley
 Map No. 1 Sec. 5 Twp. 33 R. 3E
 Well No. #1- Brooks
Van Meter Company

Contractor
DW

SECTION PLAT

7			
0			

..... Ft. from N. Line

300 Ft. from S. Line

..... Ft. from E. Line

300 Ft. from W. Line

FIRST REPORTS

Location.....

Rig up.....

Drilling and Remarks:

Rog.

RECORD

Cased..... in., ft.

Sand.....

Gas.....

Oil.....

Total Depth.....

PRODUCTION

1st 24 hrs. Nat.....

1st 24 hrs. after shot.....

Gas..... Cu. Ft.

Dry Hole.....

Abandoned.....

Date

7/13/33 O. Manschreck Secut

Map No. 1 Sec. 5 Twp. 33 R. 3E

Well No. 1- Brooks

Van Meter Company

Contractor

ABANDONED

SECTION PLAT

..... Ft. from N. Line

300 Ft. from S. Line

..... Ft. from E. Line

300 Ft. from W. Line

0			

Location.....

Rig up.....

Drilling and Remarks:

HFW
3530-35
104 H

RECORD

Cased..... in., ft.

Sand silicious 3504

Gas.....

Oil.....

Total Depth 3535

PRODUCTION

1st 24 hrs. Nat.....

1st 24 hrs. after shot.....

Gas..... Cu. Ft.

Dry Hole.....

Abandoned.....

Date

3/28/34 192 O. Mansfield Scout