


Map No. _____ Sec. 6 Twp. 33 R. 3E
Well No. 1-Wagoner Farm _____
Barnsdall Oil Company

NORTH

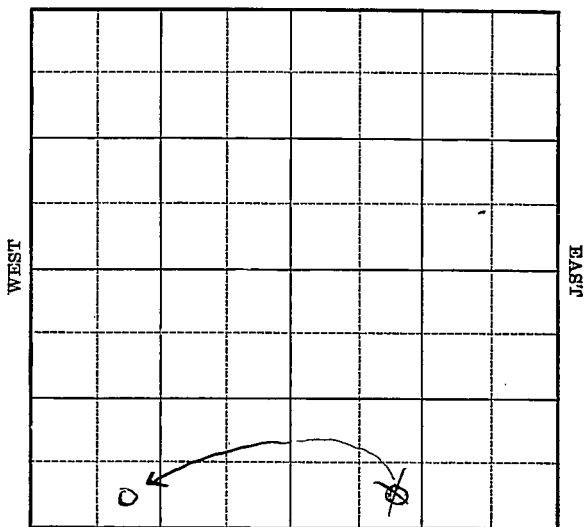

SOUTH

Location_____

Drilling Remarks

Rig Up Elav 1/20 Has

Drilling Remarks

RECORD

Cased _____ in. _____ ft.

Sand _____

Gas

Oil

Total Depth_____

PRODUCTION

1st 24 hrs. Nat. _____

1st 24 hrs. after shot_____

Gas _____ cu. ft.

Dry Hole_____

Abandoned _____


Map No. **KANSA** Sec. 6 Twp. 33 R. 3E
 Well No. 1-Waggoner Farm
Barnsdall Oil Company

_____ Ft. from N. Line

330 Ft. from S. Line

1690 Ft. from E. Line

_____ Ft. from W. Line

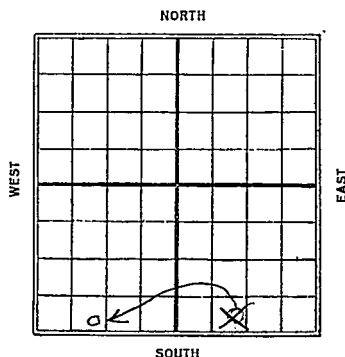

1928

Date

REPORT

4/25	Location
5/2	Rig
5/9	Spud
5/16	Drilg 345
5/23	" 1035
5/31	" 1250
6/6	" 1840
6/13	" 1935
6/20	" 2275
6/27	" 2670
7/3	T.D. 2670 - S.D.
7/11	Drilg 2650'
7/18	" 2918
7/25	Top line 3169 show oil - drilg
8/1	Drilg: 3355-
8/7	" 3460-HFW
8/15	Wellcot 3504-07
	3605 H.F.W.
	T.D. 3605' N 49 3605

Map No. 1 Cowley **KANSAS** Sec. 6 Twp. 33 R. 3E

Well No. 1 Waggoner

Barnes Oil Co. Company

Contractor

SECTION PLAT

_____ Ft. from N. Line

330 Ft. from S. Line

1690 Ft. from E. Line

_____ Ft. from W. Line

FIRST REPORTS

Location ✓

Rig up _____

Drilling and Remarks:

RECORD

Cased _____ in., _____ ft.

Sand _____

Gas _____

Oil _____

Total Depth _____

PRODUCTION

1st 24 hrs. Nat. _____

1st 24 hrs. after shot _____

Gas _____ Cu. Ft.

Dry Hole _____

Abandoned _____

Date

APR 25 1928

S. J. LEWIS

Scout

MAP NO. KANSAS SEC. 6 TWP. 33 R. 35

WELL NO. 12 Vaggoner

Barnett Oil COMPANY

CONTRACTOR

SECTION PLAT

0			

_____ FT. FROM N. LINE

830 FT. FROM S. LINE

1690 FT. FROM E. LINE

_____ FT. FROM W. LINE

Correction

LOCATION _____

RIG UP _____

DRILLING AND REMARKS:

Reported SE & SW SE
should be
SE & W. SW.

RECORD

CASED _____ IN. _____ FT.

SAND _____

GAS _____

OR _____

TOTAL DEPTH _____

PRODUCTION

1ST 24 HRS. NAT. _____

1ST 24 HRS. AFTER SHOT _____

GAS _____ CU. FT.

DRY HOLE _____

ABANDONED _____

DATE

AUG 22 1928

S. J. LEWIS

SCOUT

1 *County*
 MAP NO. **KANSAS** SEC. 6 TWP. 33 R. 3E

WELL NO. 1 Wagner

Barnes Oil Co COMPANY

CONTRACTOR

SECTION PLAT

_____ FT. FROM N. LINE

830 FT. FROM S. LINE

1690 FT. FROM E. LINE

_____ FT. FROM W. LINE

ABANDONED

LOCATION _____

RIG UP _____

DRILLING AND REMARKS:

Wilco 3504-07

3605 H.F.W.

Total Depth.

3605

L & H.

RECORD

CASED _____ IN. _____ FT.

SAND _____

GAS + _____

OIL _____

TOTAL DEPTH _____

PRODUCTION

1ST 24 HRS. NAT. _____

1ST 24 HRS. AFTER SHOT _____

GAS _____ CU. FT.

DRY HOLE _____

ABANDONED _____

DATE

AUG 22 1928

S. J. LEWIS SCOUT