


Section 7 Township 33 Range 3E

Well No. 1 Nelson

Company Ed Adair

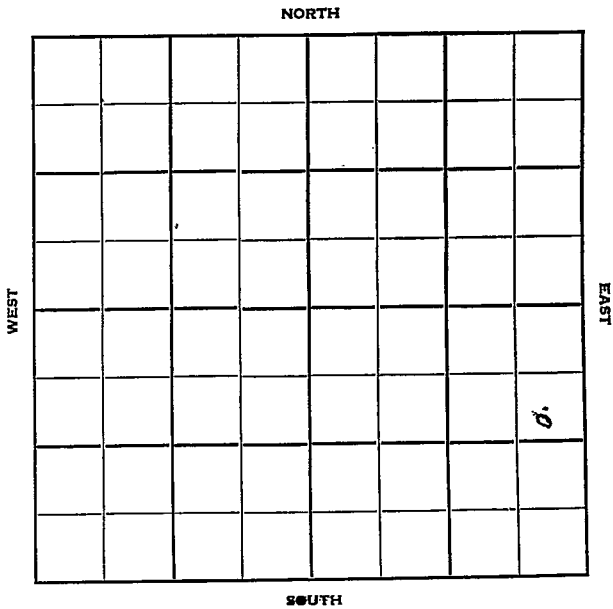

Sec. 7 Twp. 33 R. 3E ✓

Well No. #1 Nelson Farm

Ed Adair Company

Contractor


1240' Ft. from N. Line

_____ Ft. from S. Line

330' Ft. from E. Line

_____ Ft. from W. Line

SE NE SE

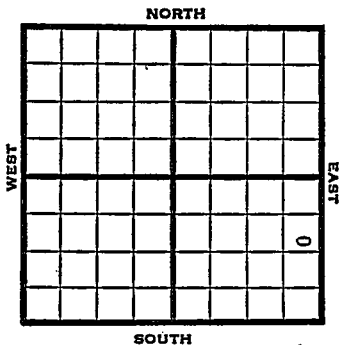

1951 Elev. 1129' REPORT

7/25 Spud 7-22-51
8" @ 73'

9/5 Spud 7-22-51
 D&A TD 3505
 8" @ 73
 Layton 2565 KC 2724 Miss. 3173
 Simp. 3488
 DST 3488-3504 open $\frac{1}{2}$ hr. rec. 28' oil
 Arb. 3501
 5" @ 3504 TD 3505 HFW SP 3495
 12/ 3484-88 6/ 3494-95 HFW
 D&A

ABANDONED

