


Map No. K Sec. 6 Twp. 33 R. 3
 Well No. 1 Albright Farm
Waite Phillips Company

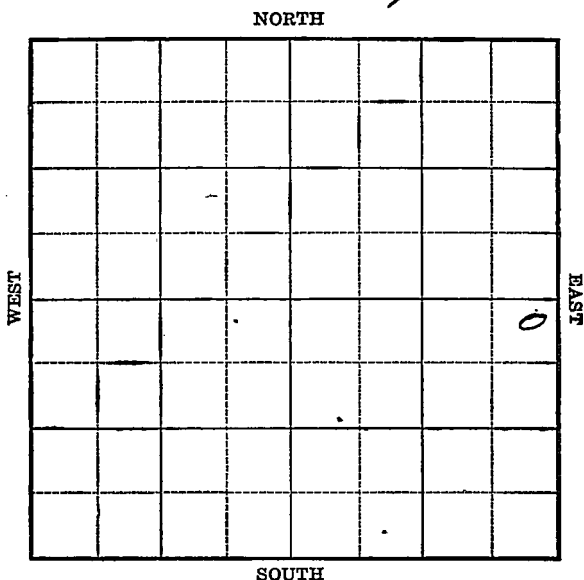

Location _____

Drilling Remarks:

RECORD

Cased _____ in. _____ ft.

Sand _____

Gas _____

Oil _____

Total Depth _____

Rig Up _____

Drilling Remarks:

PRODUCTION

1st 24 hrs. Nat. _____

1st 24 hrs. after shot _____

Gas _____ cu. ft.

Dry Hole _____

Abandoned _____

Map No. KANSAS | Sec. 6 Twp. 33 R. 3
 Well No. #1 Albright
Waite & Phillips Company

Contractor

FIRST REPORT

SECTION PLAT

200 Ft. from N. Line

_____ Ft. from S. Line

200 Ft. from E. Line

_____ Ft. from W. Line

			0

Location ✓ ✓

Rig up _____

Drilling and Remarks:

RECORD

Cased _____ in., _____ ft.

Sand _____

Gas _____

Oil _____

Total Depth _____

PRODUCTION

1st 24 hrs. Nat. _____

1st 24 hrs. after shot _____

Gas _____ Cu. Ft.

Dry Hole _____

Abandoned _____

Date

M. A. BENEAR

EB 24

192

Scout

MAP NO. _____ SEC. 6 TWP. 33S R. 3EWELL NO. 1 AlbrightH. Phillips COMPANY

CONTRACTOR

SECTION PLAT

_____ FT. FROM N. LINE

_____ FT. FROM S. LINE

_____ FT. FROM E. LINE

_____ FT. FROM W. LINE

RECORD

LOCATION _____

CASED _____ IN. _____ FT.

RIG UP _____

SAND _____

DRILLING AND REMARKS:

GAS _____

OIL _____

TOTAL DEPTH 384'

PRODUCTION

1ST 24 HRS. NAT. _____

1ST 24 HRS. AFTER SHOT _____

GAS _____ CU. FT.

DRY HOLE ☒ABANDONED ☒

DATE

9/16 192 ✓ SCOUT

K1 **KANSAS** Sec. 6 Twp. 33 R. 3
 Map No. _____
 Well No. 1 Albright
Wait & Phillips Company
 _____ Contractor

ABANDONED**SECTION PLAT**200 Ft. from N. Line

_____ Ft. from S. Line

200 Ft. from E. Line

_____ Ft. from W. Line

			0

Location _____

Rig up _____

Drilling and Remarks:

Tap L. 3181LOT 9 3842**RECORD**

Cased _____ in., _____ ft.

Sand _____

Gas _____

Oil _____

Total Depth _____

PRODUCTION

1st 24 hrs. Nat. _____

1st 24 hrs. after shot _____

Gas _____ Cu. Ft.

Dry Hole _____

Abandoned _____

Date **OCT 8 1924****M. A. BENEAR**

192

Scout