

Map No. **KANSAS** Sec. **7** Twp. **33** R. **3E**


Well No. **1-Roberts** Farm
Barnsdall Company

_____ Ft. from N. Line

990 Ft. from S. Line

330 Ft. from E. Line

_____ Ft. from W. Line

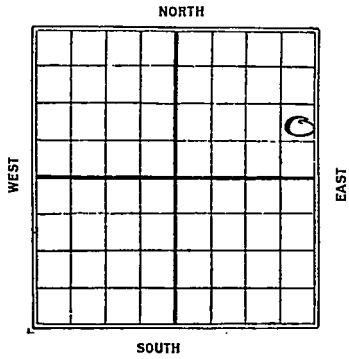

1927

Date	REPORT <i>Elev 1123 & 5</i>
<i>11/30</i>	<i>Rig</i>
<i>12/7</i>	<i>[Signature]</i>
<i>12/14</i>	<i>Spud</i>
<i>12/21</i>	<i>Drlg 365</i>
<i>12/28</i>	<i>" 825</i>
<i>1928</i>	
<i>1/4</i>	<i>Drlg 1460</i>
<i>1/11</i>	<i>" 1790</i>
<i>1/18</i>	<i>" 1950</i>
<i>1/25</i>	<i>S.D. 2000</i>
<i>1/31</i>	<i>Drlg 2160</i>
<i>2/15</i>	<i>" 2760</i>
<i>2/22</i>	<i>" 2865</i>
<i>2/29</i>	<i>Chat 3165-85 - Sand 3192-3200</i>
	<i>2 bailers oil per hr - Drlg 3200-</i>
<i>3/7</i>	<i>Top sil. line 3480-</i>
<i>3/14</i>	<i>T.D. 3490 - pumped</i>
	<i>175 bbls. 24 hrs. 40.5 gravity-</i>
<i>3/21</i>	<i>Top sil. line 3480</i>
	<i>T.D. 3490</i>
	<i>115 bbls per hr</i>

County Cowley
Map No. KANSAS Sec. 7 Twp. 33 R. 3E

Well No. 1 Roberts

Barnwell et al. Company

Contractor

SECTION PLAT

			o

----- Ft. from N. Line

990 Ft. from S. Line

330 Ft. from E. Line

----- Ft. from W. Line

FIRST REPORTS

Location -----

Rig up -----

Drilling and Remarks:

Rig

RECORD

Cased ----- in., ----- ft.

Sand -----

Gas -----

Oil -----

Total Depth -----

PRODUCTION

1st 24 hrs. Nat. -----

1st 24 hrs. after shot -----

Gas ----- Cu. Ft.

Dry Hole -----

Abandoned -----

Date

NOV 30, 1927

S. J. LEWIS

Scout

Map No. **KANSAS** Sec. *7* Twp. *33* R. *2E*

Well No. *1 Roberts*

Barnesclark et al Company

Contractor

SECTION PLAT

			o

----- Ft. from N. Line

990 Ft. from S. Line

220 Ft. from E. Line

----- Ft. from W. Line

COMPLETED

RECORD

Location -----

Rig up -----

Drilling and Remarks:

Top. C. L. 3480

TII 3490

115 8 1/2 pumpers

Cased ----- in., ----- ft.

Sand -----

Gas -----

Oil -----

Total Depth -----

PRODUCTION

1st 24 hrs. Nat. -----

1st 24 hrs. after shot -----

Gas ----- Cu. Ft.

Dry Hole -----

Abandoned -----

Date

MAR 21 1928

S. J. LEWIS

Scout