

Cowley


KANSAS

Form 51—5M—7-39—Palace

Section 30 Township 30 Range 4-E

Well No. #1 Dickinson

Company O. J. Connell

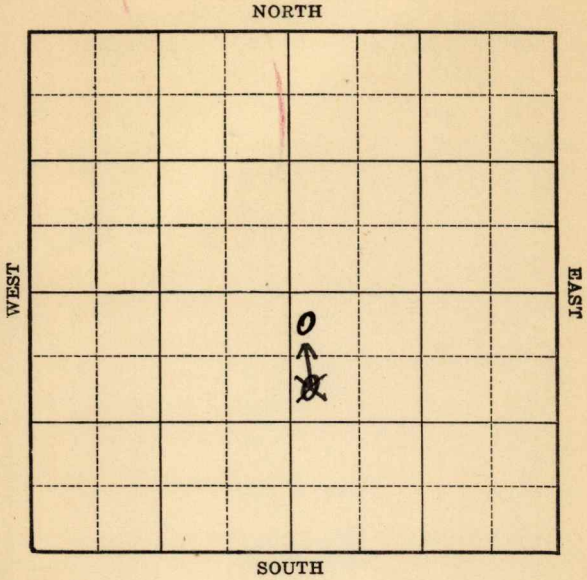

KANSAS

Cowley

Sec. 30 Twp. 30 R. 4-EWell No. #1 Dickinson FarmO. J. Connell Company

(Rock)

~~290~~ 330


Ft. from N. Line

Ft. from S. Line

Ft. from E. Line

160~~250~~

Ft. from W. Line

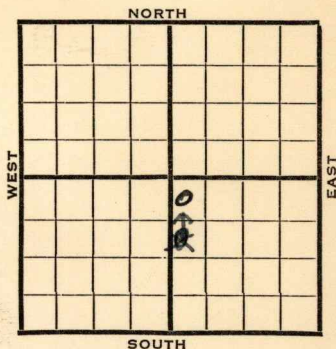

1940

REPORT

4/3

Machine.

4/12

"

4/18

15" - 201' Drlg. 795'

4/25

12" - 1178' Drlg. 1530'

5/2

1714' run 10".

5/9

10" - 1714' 8" - 2191'

Drlg. 2330'

5/16

6" - 2572' Drlg. 2735'

5/22

6" - 2572'

T.D. 2885'

No Bart. sand.

ABANDONED

Cowley

Map No. 11 Sec. 30 Twp. 30 R. 4EWell No. 1 DickinsonO. J. Connell Company

Contractor

FIRST REPORT

SECTION PLAT

SW NW SE

990 Ft. from N. Line Ft. from S. Line Ft. from E. Line250 Ft. from W. Line

ROCK POOL

Location Rig up

Drilling and Remarks:

Machine

RECORD

Cased in., ft.Sand Gas Oil Total Depth

PRODUCTION

1st 24 hrs. Nat. 1st 24 hrs. after shot Gas Cu. Ft.Dry Hole Abandoned

Date

APR 3 1919

S. J. LEWIS

Scout

Map No. // Sec. 30 Twp. 30 R. 4EWell No. 1 DickersonO. J. Connell CompanyCORRECTION Contractor

SECTION PLAT

NW SE

330 Ft. from N. Line Ft. from S. Line Ft. from E. Line160 Ft. from W. Line

		o	

ROCK POOL

Location Rig up

Drilling and Remarks:

Reported

SW NW SE

RECORD

Cased in., ft.Sand Gas Oil Total Depth

PRODUCTION

1st 24 hrs. Nat. 1st 24 hrs. after shot Gas Cu. Ft.Dry Hole Abandoned

Date

APR 20 1940

19

S. J. LEWIS

Scout

Map No. 11 Sec. 30 Twp. 30 R. 4EWell No. 1 DickinsonO. J. Connell Company

Contractor

ABANDONED**NW SE**330 Ft. from N. Line Ft. from S. Line Ft. from E. Line160 Ft. from W. Line

Rock Pool

SECTION PLAT

		o	

Location Rig up

Drilling and Remarks:

6" C2572No Bart. Sand.**RECORD**Cased in., ft.Sand Gas Oil Total Depth 2885**PRODUCTION**1st 24 hrs. Nat. 1st 24 hrs. after shot Gas Cu. Ft.Dry Hole Abandoned

Date

MAY 22 1940 19S. J. LEWIS Scout