


Map No. **KANSAS** Sec. 7 Twp. 33 R. 3E
Well No. 1-Patterson Farm
Barnsdall oil Company

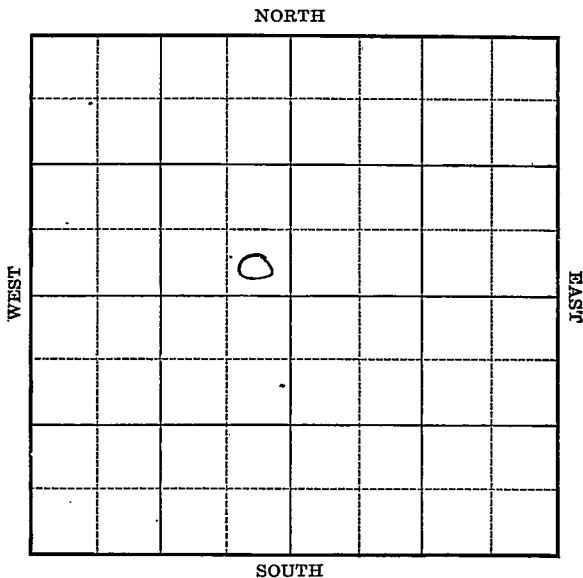

Location _____

Drilling Remarks _____

RECORD

Cased _____ in. _____ ft.

Sand _____

Gas _____

Oil _____

Total Depth _____

Rig Up _____

Drilling Remarks _____

PRODUCTION

1st 24 hrs. Nat. _____

1st 24 hrs. after shot _____

Gas _____ cu. ft.


Dry Hole _____

Abandoned _____

Map No. **KANSAS** Sec. 7 Twp. 33 R. 35

Well No. 1 - Patterson Farm
Barnsdall Oil Company

_____ Ft. from N. Line
330 Ft. from S. Line
330 Ft. from E. Line
 _____ Ft. from W. Line

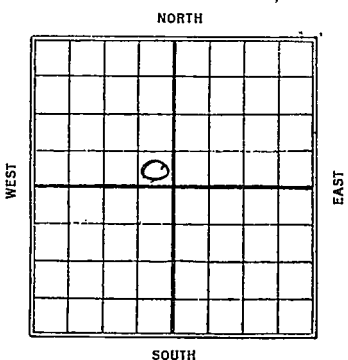

1927

Date	REPORT
<u>10/26</u>	<u>Big Bldg.</u>
<u>11/2</u>	<u>rigging up</u>
<u>11/9</u>	<u>Spud 450</u>
<u>11/16</u>	<u>Drly 815</u>
<u>11/22</u>	<u>" " 1275</u>
<u>11/29</u>	<u>" " 1650</u>
<u>12/7</u>	<u>" " 1885</u>
<u>12/14</u>	<u>" " 1970</u>
<u>12/21</u>	<u>" " 2310</u>
<u>12/28</u>	<u>" " 2835</u>
<u>1928</u>	
<u>1/4</u>	<u>Drly 2957</u>
<u>1/11</u>	<u>" " 3257</u>
<u>1/18</u>	<u>Top line 3368 - Drly 3385 -</u>
<u>1/25</u>	<u>Shilpe 3604 - 08</u>
	<u>Sil. line 3608 - 3636</u>
	<u>T.D. 3636</u>

Map No. KANSAS Sec. 7 Twp. 33 R. 14

Well No. 1 Patterson

Barnsdall Oil Company

Contractor

SECTION PLAT

		0	

----- Ft. from N. Line

380 Ft. from S. Line

330 Ft. from E. Line

----- Ft. from W. Line

FIRST REPORTS

Location -----

Rig up -----

Drilling and Remarks:

Rig Bldg

RECORD

Cased ----- in., ----- ft.

Sand -----

Gas -----

Oil -----

Total Depth -----

PRODUCTION

1st 24 hrs. Nat. -----

1st 24 hrs. after shot -----

Gas ----- Cu. Ft.

Dry Hole -----

Abandoned -----

Date

OCT 26 1927

S. J. LEWIS

Scout

MAP No. _____ SEC. 7 TWP. 33S R. 3E

WELL No. 1 Patterson
Barnes COMPANY

CONTRACTOR _____

SECTION PLAT

_____ FT. FROM N. LINE
_____ FT. FROM S. LINE
_____ FT. FROM E. LINE
_____ FT. FROM W. LINE

LOCATION ex

RIG UP: _____

DRILLING AND REMARKS:
3604-11
Waterdry
3611-3637
oil line
AD. W

RECORD

CASED _____ IN., _____ FT.
SAND _____
GAS _____
OIL _____
TOTAL DEPTH 3637

PRODUCTION

1ST 24 HRS. NAT. _____
1ST 24 HRS. AFTER SHOT _____
GAS _____ CU. FT.
DRY HOLE
ABANDONED

DATE 1/24 1928

SCOUT _____

Map No. KANSAS Sec. 7 Twp. 22 R. 2E

Well No. 1 Patterson

Barnwell Oil Company

Contractor

SECTION PLAT

_____ Ft. from N. Line

330 Ft. from S. Line

330 Ft. from E. Line

_____ Ft. from W. Line

ABANDONED

RECORD

Location _____

Cased _____ in., _____ ft.

Rig up _____

Sand _____

Drilling and Remarks:

Gas _____

Wilcox 3604-08

Oil _____

Silk 3608-3636

Total Depth _____

VI 3636

PRODUCTION

II 3636

1st 24 hrs. Nat. _____

1st 24 hrs. after shot _____

Gas _____ Cu. Ft.

Dry Hole _____

Abandoned _____

Date

JAN 25 1928

S. J. LEWIS

192

Scout