

Cowley

KANSAS

SECTION 30

TOWNSHIP

30

RANGE

4E


WELL NO.

#2 Hufford

COMPANY

W.W. West

NORTH

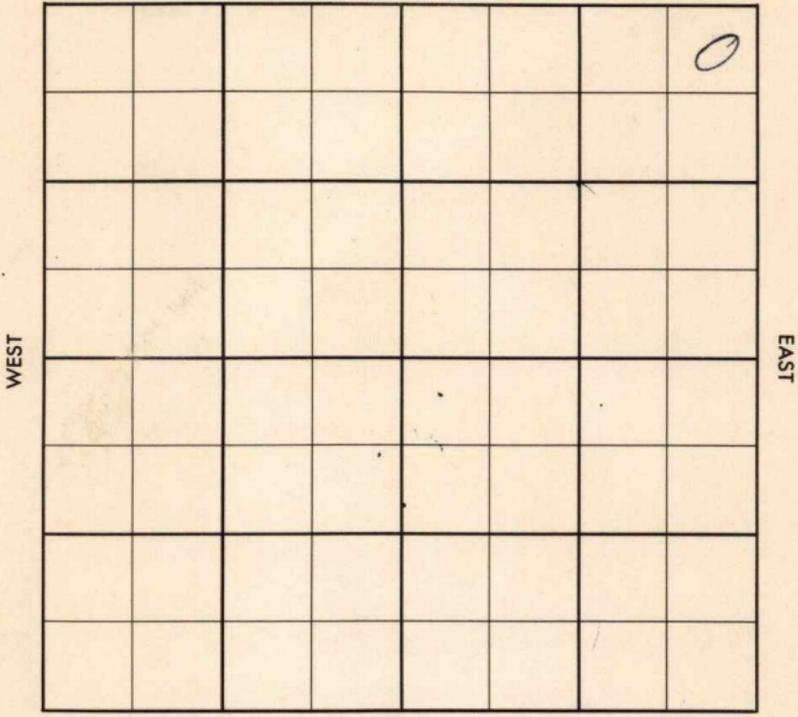

SOUTH

WEST

EAST

County Cowley Elev. _____
 Sec. 30 Twp. 30 Rge. 4E
 Company W. W. West
 Farm Name Hufford No. 2

TOPS	DEPTH	LOG	DATUM
Anh.			
Tp.			
H.			
Tr.			
Dg.			
Bl.			
L.			
K.C.			
B.K.C.			
Ce.			
C.			
M.			
M.			
K.			
Mz.			
Mq.			
V.			
S.			
S.			
A.			
R.			
Pe.			
G.			
T.D.			

Loc. in Sec. _____
NE NE NE
200' EL
 Geol. _____
 Contr. _____
Capitt Drlg.
 Pool _____
Rock

FIRST REPORT

DEC 12 1956

Date Comm. 12-7-56
8" @ 93 drlg. 21/1

~~29~~

Co. No. Sec. T. R.

County Cowley Elev. _____
 Sec. 30 Twp. 30 Rgs. 1/E
 Company W. W. West
 Farm Name Hufford No. 2

TOPS	DEPTH	LOG	DATUM	Loc. in Sec.
Anh.				NE NE NE
Tp.				200' EL
H.				
Tr.				
Dg.				
Bl. <u>Bart/zn</u>	<u>2850</u>			
L.				
K.C.				Geol. _____
B.K.C.				Contr. _____
Ce.				<u>Capitt Drlg.</u>
C.				
M.				Pool _____
M.				Rock _____
K.				
Mz.				
Me				
V.				
S.				
S.				
A.				
R.				
PE.				
G.				
T.D.	<u>2870</u>			

DEC 20 1956
 ABANDONE

Date Comm. 12-7-56
8" @ 93 drlg. 2141 DEC 19 1956

D E A