

Barton


FORM 51

KANSAS

Section 26 Township 17 Range 11W

Well No. #3 Norris "A"

Company Morris Sitrin

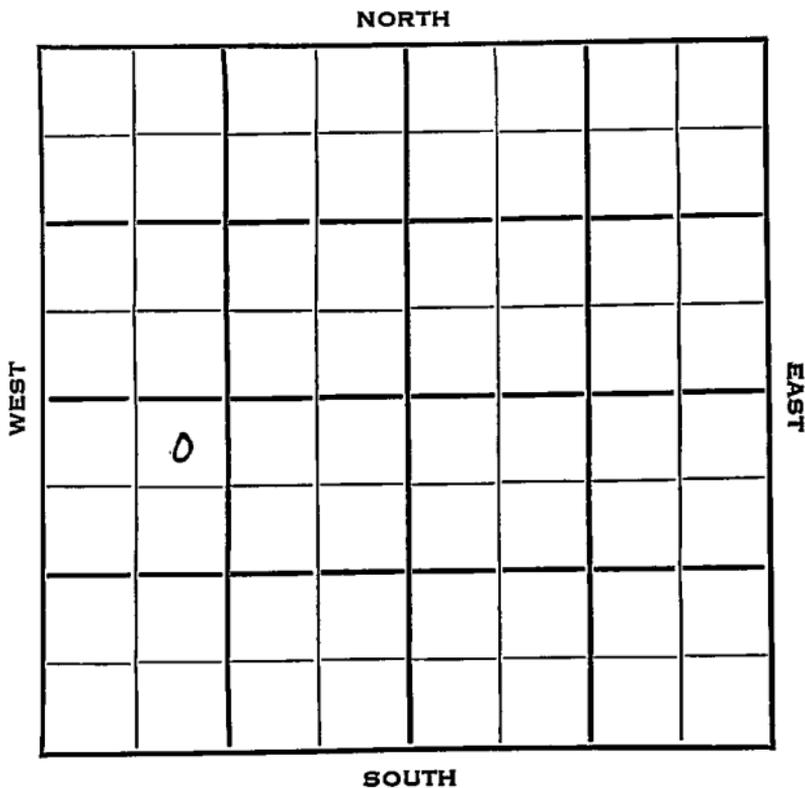

SEC.	TWP.	R.
26	17	11W ✓

WELL NO. #3 Norris "A" FARM

COMPANY Morris Sitrin

CONTRACTOR Garvey

Kraft-Prusa Pool

NORTH

Ft. from N. Line

Ft. from S. Line

Ft. from E. Line

Ft. from W. Line

WEST

EAST

SOUTH

NE NW SW

1953	ELEVATION	REPORT
	1843'	

- 10/4 Spud 11-1-53
8" @ 224'
- 11/11 Anhy 643'
DST 3073-85', 1 hr., 2 M gas, 45#
OCM, 60' GCO, 615#
DST 3096-3125', 1 hr., 57' SOCM, 395#
- 11/18 Wea Arb. 3279'
Arb. 3286'
RTD 3290'
5" @ 3287'
- 12/9 NR
- 12/30 Spud 11-1-53
Oil Well
TD 3290'
8" @ 224'
Anhy 643', Heeb 2886', Br. Lime 2994'
Lans 3008'
DST 3073'-85' opn 1 hr, rec 2 mcfg
45' ocm 60' gco 615#
DST 3096'-3125' opn 1 hr, rec 57' socm
395# Weathered Arb 3279'. Arb 3286'
TD 3290'
5" @ 3287'
CO to 3290' FU 2280' oil
Comp 218 bopd.

COMPLETED

County Barton State Kansas

Sec. 26 (Blk. 17 (Sur. 11W (Twp.) Rge.) Map No.

Operator Morris Sitrin

Well No. 3 Farm Norris "A"

Elev. 1843 Location NE NW SW

COMPLETE									
0									

330 Ft. From S Line SW

990 Ft. From W Line Quarter

Ist. Report

Completion DEC 30 1953

Remarks Kraft-Prusa Pool

Garvey - Contr.

Spudding Date 11-1-53

Drlg. Data Oil well TD 3290

8" @ 224 Anhy 643 Heeb. 2886

Br. lime 2994 Lans. 3008 DST 3073-85

open 1 hr. Rec. 2 mcfg 45' ocm 60' gco

615# DST 3096-3125 open 1 hr. Rec. 57'

socm 395# weathered Arb. 3279

Arb. 3286 TD 3290 5" @ 3287 CO to 3290

FU 2280' oil Comp. 218 bopd