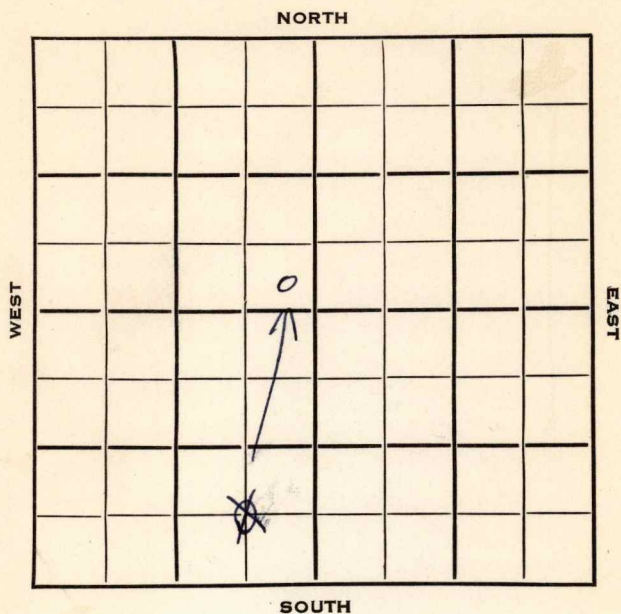


Section 30 Township 30 Range 4 EWell No. # 1 Tittsworth (*Tittsworth*)Company L. C. Smitherman

Cowley

KANSAS

SEC.	TWP.	R.
30	30	4 E ✓

WELL NO. _____

COMPANY # 1 Tittsworth FARM

CONTRACTOR L. C. Smitherman


Trees Pool

Ft. from N. Line

~~660~~ 200 Ft. from S. Line

~~660~~ 250 Ft. from E. Line

Ft. from W. Line

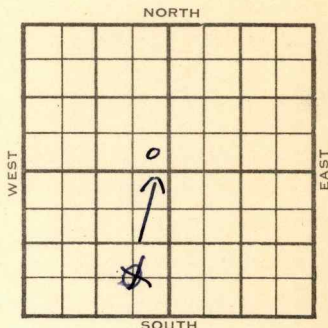

~~C SE SW~~
SE SE NW

	ELEVATION	REPORT
1953	--	
12/16	Bart 2860'	5" @ 2861 TD 2870' WOCT
1954 1/6	Oil Well TD 2870' Bart 2860' 5" @ 2861' TD 2870' CO to 2870 Hydro Comp. 5 bopd 10 bw	

COMPLETED

County Cowley State KansasSec. 30 (Blk.) 30 (Sur.) 4 E Map No.Operator L. C. SmithermanWell No. 1 Farm TitsworthElev. Location C SE SW660 Ft. From S Line SW660 Ft. From E Line Quarter1st. Report DEC 16 1953

Completion

Remarks

Spudding Date

Drig. Data Trees PoolBart. 2860 5" @ 2861 TD 2870 WOCT

J. G. McGEHEE

County Cowley State Kansas
 Sec. 30 (Blk. 30 (Sur. 4E (Twp. Map No.
 Operator L. C. Smitherman
 Well No. 1 Farm Titworth
 Elev. _____ Location C SE SW



660 Ft. From S Line SW
660 Ft. From E Line Quarter
 1st. Report _____
 Completion JAN 6 1954
 Remarks Trees Pool
 Spudding Date _____

Drlg. Data Oil well TD 2870
Bart. 2860 5" @ 2861 TD 2870
CO to 2870 Hydro. Comp. 5 bopd 10 bw

J. G. McGEHEE

Kansas

Map No. _____ Sec. 30 Twp. 30 R. 4EWell No. 1 TitsworthL. C. Smitherman CompanyCORRECTION Contractor

SE SE NW

SECTION PLAT

_____ Ft. from N. Line

200 Ft. from S. Line250 Ft. from E. Line

_____ Ft. from W. Line

Cowley County

Location _____

Rig up _____

Drilling and Remarks:

Completed

1-6-54

C SE SW

RECORD

Cased _____ in., _____ ft.

Sand _____

Gas _____

Oil _____

Total Depth _____

PRODUCTION

1st 24 hrs. Nat. _____

1st 24 hrs. after shot _____

Gas _____ Cu. Ft.

Dry Hole _____

Abandoned _____

Date

JAN 20 1954

19

J. G. McGEHEE

Scout