


Cowley

KANSAS

Section 30 Township 30 Range 4E

Well No. #2 Titsworth (*Tittsworth*)

Company Trees Oil

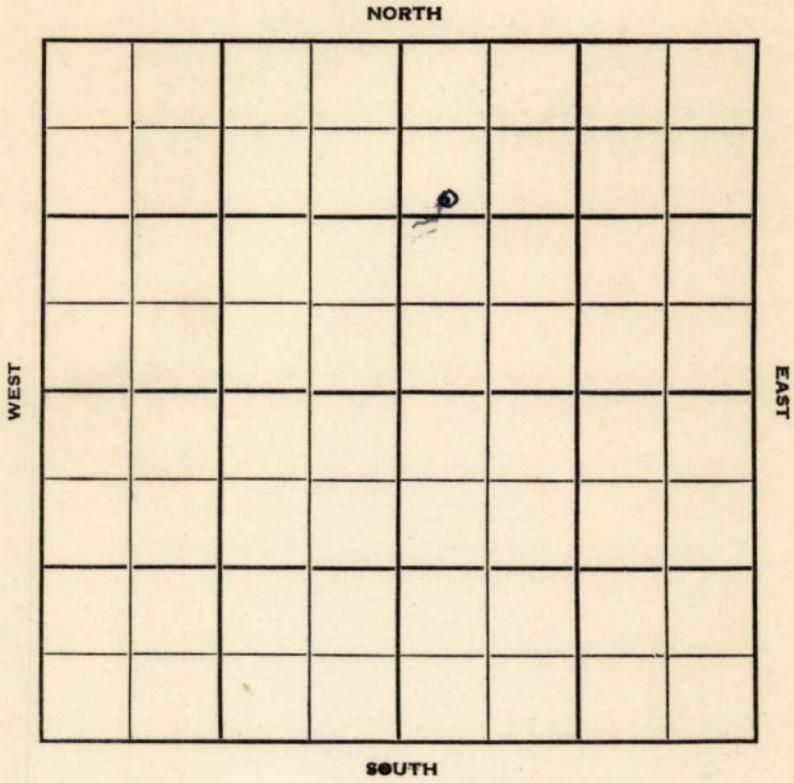

Cowley  
30

**KANSAS**

4E

Sec. 30 Twp. 30 R. 4E

Well No. #2 Titsworth Farm \_\_\_\_\_

Trees Oil Company \_\_\_\_\_

Contractor \_\_\_\_\_

Trees Pool


1170' Ft. from N. Line

\_\_\_\_\_ Ft. from S. Line

\_\_\_\_\_ Ft. from E. Line

450' Ft. from W. Line

SW NW NE

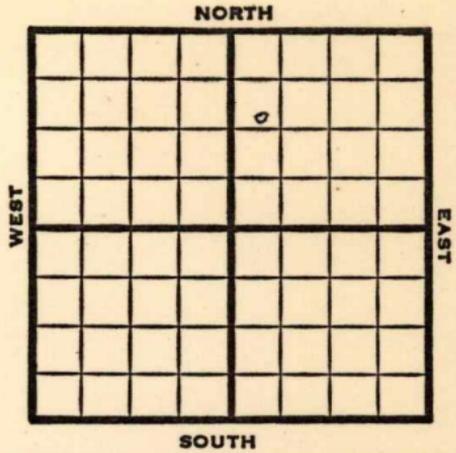

1951

**Elev. 1157'** REPORT

5/2

Set Surface

8/22

Spud 6-13-51  
Oil Well TD 2861

8" @ 96

Stal 1984 Layton 2170-2230

Bart 2852 KC 2327

5" @ 2852

Basal sand 2859

TD 2861

Hydrafrac Comp. 15 bopd

**COMPLETED**



County Cowley State Kansas

Sec. 30 (<sup>Bk.</sup>30) (<sup>Sur.</sup>4E) (<sup>Twp.</sup>30) Map No.

Operator Trees Oil

Well No. 2 Farm Titsworth

Elev. 1157 Location SW NW NE

		0			

1170 Ft. From N Line NE

450 Ft. From W Line Quarter

1st. Report

Completion AUG 22 1951

Remarks Trees Pool

Spudding Date 6-13-51

Drlg. Data Oil well TD 2861

8" @ 96 Stal. 1984 Layton 2170-2230

Bart. 2852 KC 2327 5" @ 2852

Basal sand 2859 TD 2861 Hydrofrac

Comp. 15 bopd