


Section 26 Township 17 Range 11W

Well No. #3 Staatz

Company Morris Sitrin & Fleming (was Flourney)

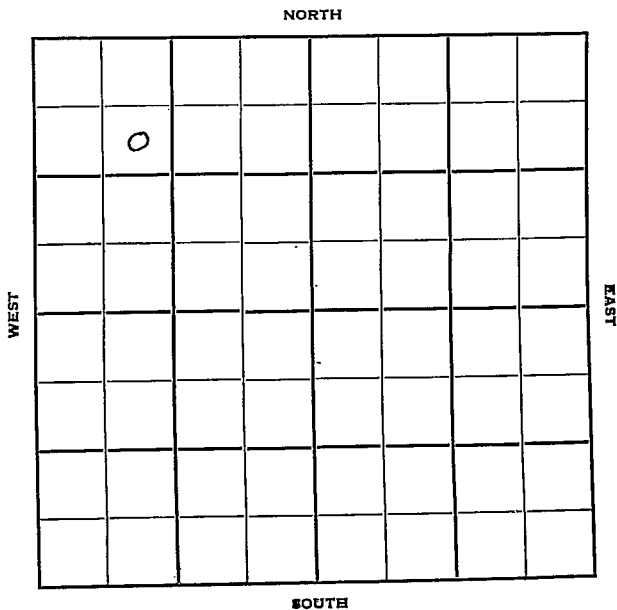

Barton

KANSAS

Sec. 26 Twp. 17 R. 11W

Well No. #3 Staatz Farm

Morris Sitrin & Fleming (was Flourney) Company

Garvey Contractor


990 Ft. from N. Line

\_\_\_\_\_ Ft. from S. Line

\_\_\_\_\_ Ft. from E. Line

990 Ft. from W. Line

NW  $\frac{1}{4}$  SE NW NW

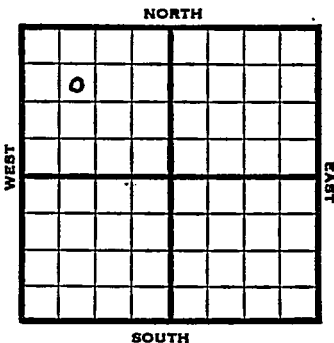

1952 Elev. 1853' REPORT

- 11/5 Spud 10-27-52  
8" @ 215'  
Lans 3029'  
DST 3099-3110', opn  $\frac{1}{2}$  hr., rec. 720'  
sw 300' gcm 1000#  
Arb 3315'  
Drlg. 3356'
- 11/12 (RTD 3327' Cor) 5" @ 3317'  
DST 3317-27, 2 hrs, 190' OCM CO  
8 to 10 BOPH POP
- 11/20 NR
- 11/27 NR
- 12/4 NR
- 12/11 NR
- 12/25 NR
- 1/1 NR
- 1/8 NR
- 1/22 NR
- 1/29 "
- 2/5 NR
- 2/12 P/50 BFPD 90% wtr.
- 2/19 NR
- 2/26 "

**OVER**

1953  
3/12 NR  
3/19 P/9 BOPD  
3/26 NR  
4/2 NR  
4/9 "  
4/16 NR  
4/23 "  
4/30 "  
5/7 "  
5/21 "  
5/27 Spud 10-27-52  
D & A  
TD 3327'  
8" @ 215'  
Lans 3029  
DST 3099-3110 opn  $\frac{1}{2}$  hr, rec 720' sw.  
300' gcm 1000# Arb 3315  
TD 3327  
5" @ 3317'  
DST 3317-27 opn 2 hr, rec 190' ocm  
8 to 10 boph P/ 50 bfpd 90% wtr.  
D & A

**ABANDONED**



