


Section 26 Township 17 Range 11W

Well No. #4 Staatz

Company Fleming & Sitrin

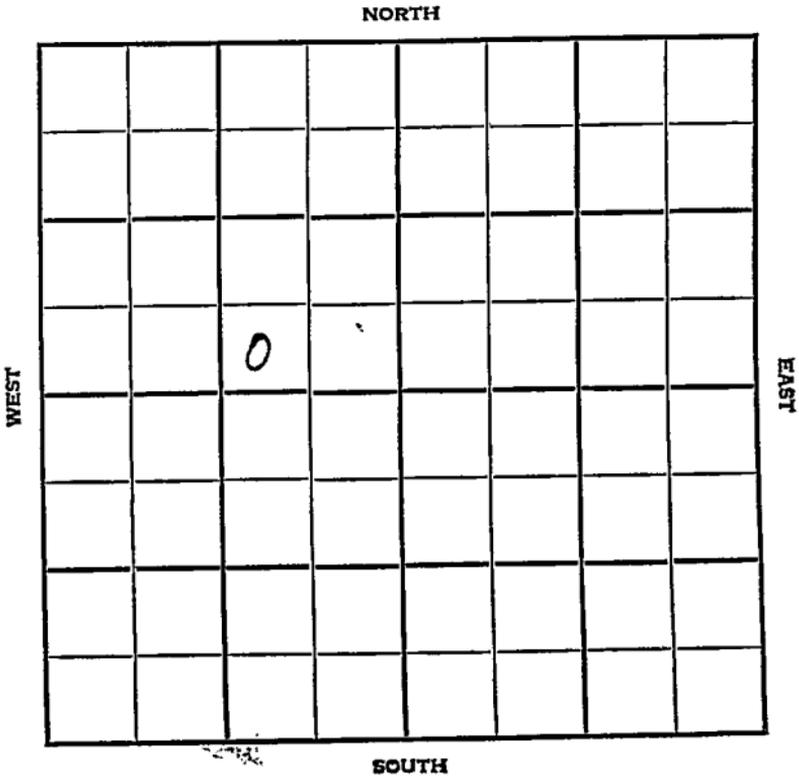

SEC.	TWP.	R.
26	17	11W

WELL NO. #4 Staatz FARM

COMPANY Fleming & Sitrin

CONTRACTOR

Kraft-Prusa Pool

NORTH

Ft. from N. Line

330 Ft. from S. Line

990 Ft. from E. Line

Ft. from W. Line

		0					

WEST

EAST

SOUTH

SW SE NW

	ELEVATION	REPORT
1955	1846'	
2/23		Spud 2-22-55
4/13		Spud 2-22-55 Oil well TD 3313 8" @ 225 Anhy 649 Top 2641' DST 2840-49 open 40 min, rec 8' OCM 940# Heeb 2893 Br. lime 3001 KC 3013 BKC 3255 ReArb. 3284 DST 3282-93 open 1-3/4 hr, gas in 2 mi 2,190,000 CFG, rec 90' OCGM 525# Arb. 3292 DST 3289-3301 open 1 1/2 hr. rec 35' OCM 650# DST 3 296-3313 open 1 hr rec 55' oil, 200' HOCM, 700# TD 3313' 5" @ 3297 CO to 3313 FU 450' oil 15 hr. S/1 1/4 BOPH 4 hr. PB 3311 500 A S/2 to 3 BOPH 1000 A S/4 BOPH 3 hr FU 1900' oil, 40' wtr. 2 days. S/1 1/2 BOPH Comp. 35 BOPD
COMPLETED		

