
KANSAS Barton County

FORM 51 5M PETROL

Section 27 Township 17 Range 11W

Well No. 1 Morris

Company Black-Marshall

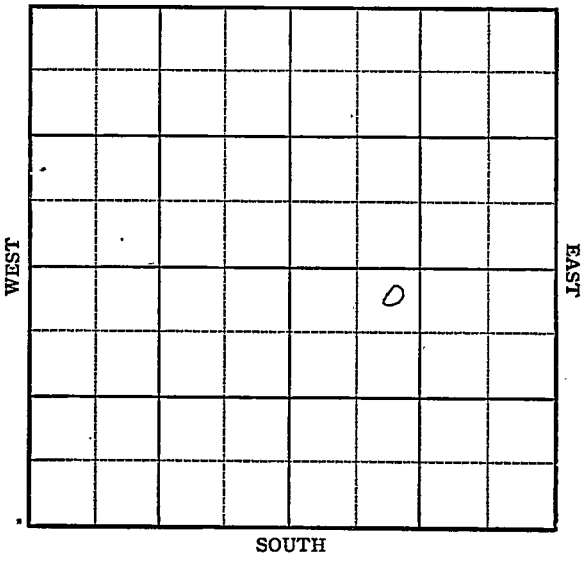

FORM 252-A
5M 3-45 PETROL

KANSAS Barton

Sec. 27 Twp. 17 R. 11W

Well No. 1 Morris Farm

Black-Marshall Company

Kraft-Pruss


330 Ft. from N. Line

_____ Ft. from S. Line

_____ Ft. from E. Line

990 Ft. from W. Line

NE NW SE Elev. 1811

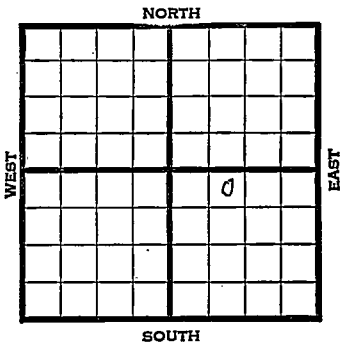

1945	REPORT
5/23	Location
6/6	Lans 3030 Cong 3279 Arb. 3341 TD 3371'

ABANDONED

FORM 26 200 BKS 2-44 PRINTED

Kansas Pool Name Kraft-Prusa

Map No. 55 Sec. 27 Twp. 17 R. 11W

Well No. 1 Morris

Black-Marshall Company

FIRST REPORT Contractor

NE NW SE

330 Ft. from N. Line


Ft. from S. Line

Ft. from E. Line

990 Ft. from W. Line

Barton

SECTION PLAT

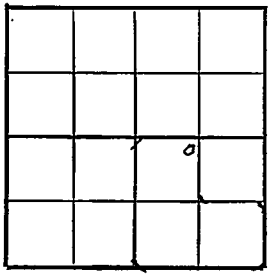

Location X

Rig up

Drilling and Remarks:

RECORD

Cased in., ft.

Sand

Gas

Oil

Total Depth

PRODUCTION

1st 24 hrs. Nat.

1st 24 hrs. after shot

Gas Cu. Ft.

Dry Hole

Abandoned

Date

MAY 23 1945 19 S. I LEWIS Scout

FORM 26 200 BKS. 2-44 PETROL

Kansas Pool Name Kraft-Prusa

Map No. S S Sec. 27 Twp. 17 R. 11W

Well No. 1 Morris


Black-Marshall Company

ABANDONED Contractor

NE NW SE

E.1.1811

SECTION PLAT

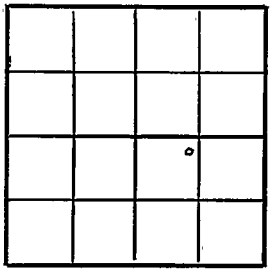

330 Ft. from N. Line

Ft. from S. Line

Ft. from E. Line

990 Ft. from W. Line

Barton County

Location

Rig up

Drilling and Remarks:

Lans 3030
Conq 3279
Cong 3341

RECORD

Cased in., ft.

Sand

Gas

Oil

Total Depth 3371

PRODUCTION

1st 24 hrs. Nat.

1st 24 hrs. after shot

Gas Cu. Ft.

Dry Hole

Abandoned

Date

JUN 6 1945 19

S. J. LEWIS Scout