


Section 27 Township 17 Range 11-W

Well No. #2, Praeger

Company Phillips Petroleum Corporation

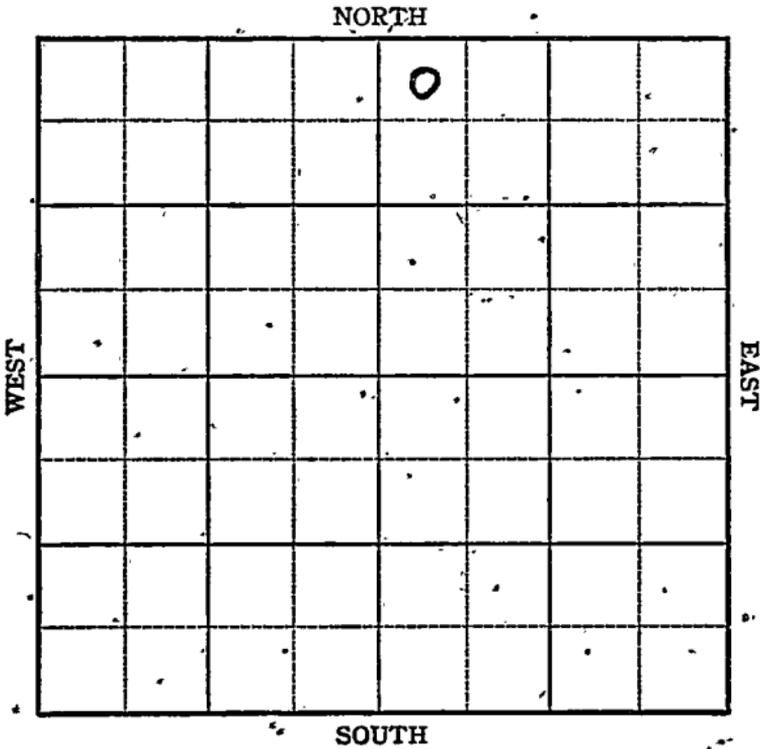

Sec. 27 Twp. 17 R. 11-W

Well No. #2, Praeger Farm

Phillips Pot. Company


Kraft-Prusa

330' Ft. from N. Line

Ft. from S. Line

330' Ft. from E. Line

Ft. from W. Line

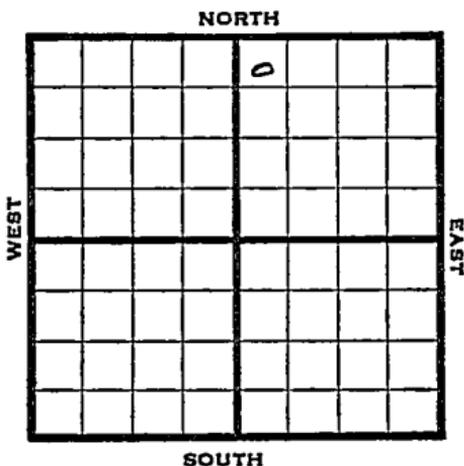

NW NE

1947 Elev. 1832 REPORT

1/22 Location

2/5 Drlg 2555'

2/12  
Lans 3018'  
Cong 3283'  
Arb 3293  
TD 3319  
SD

2/19  
Lans 3018  
Arb 3293  
TD 3319'

ABANDONED

KANSAS

Map No. 55 Sec. 27 Twp. 17 R. 11W

Well No. 2 Praeger

Phillips Company

**FIRST REPORT**

Contractor

NW NE

**SECTION PLAT**

330 Ft. from N. Line

         Ft. from S. Line

330 Ft. from E. Line

         Ft. from W. Line

		0	

Barton County

Location X

Rig up         

Drilling and Remarks:

**RECORD**

Cased          in.,          ft.

Sand         

Gas         

Oil         

Total Depth         

**PRODUCTION**

1st 24 hrs. Nat.         

1st 24 hrs. after shot         

Gas          Cu. Ft.

Dry Hole         

Abandoned         

Date

JAN 2 2 1947<sub>19</sub>

S. J. LEWIS Scout

Kansas KANSAS

Map No. 55 Sec. 27 Twp. 17 R. 11W

Well No. 2 Praeger

Phillips Company

**ABANDONED**

Contractor

NW NE .

*E/1832*


**SECTION PLAT**

330 Ft. from N. Line

         Ft. from S. Line

330 Ft. from E. Line

         Ft. from W. Line

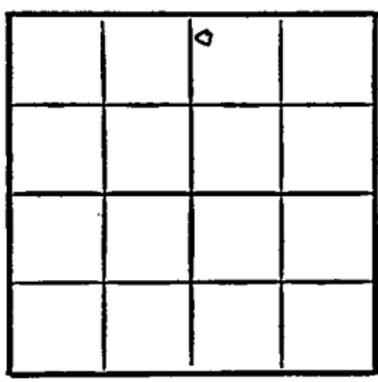

Barton County

Location \_\_\_\_\_

Rig up \_\_\_\_\_

Drilling and Remarks:

*Lans 3018*  
*2/13/29*

**RECORD**

Cased \_\_\_\_\_ in, \_\_\_\_\_ ft.

Sand \_\_\_\_\_

Gas \_\_\_\_\_

Oil \_\_\_\_\_

Total Depth 2319

**PRODUCTION**

1st 24 hrs. Nat. \_\_\_\_\_

1st 24 hrs. after shot \_\_\_\_\_

Gas \_\_\_\_\_ Cu. Ft.

Dry Hole \_\_\_\_\_

Abandoned \_\_\_\_\_

Date

FEB 19 1947 19

S. J. LEWIS Scout