

KANSAS

Barton



Sec. 29 Twp. 17 R. 11W

Well No. #1 Nagel Farm _____

Central Oil Company


Wildcat

_____ Ft. from N. Line

330' Ft. from S. Line

330' Ft. from E. Line

_____ Ft. from W. Line

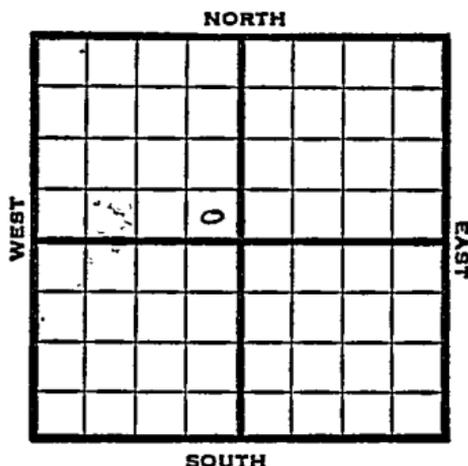

SE NW

1949

Elev 1821' REPORT

2/23

Location

3/2

8" @ 190' SD

3/8

Drlg 1600'

3/16

TD 3405'

Lans. 3058'

Arb. 3390'

Aband.

ABANDONED

Map No. _____ Sec. 29 Twp. 17 R. 11W

Well No. I Nagel

Central Oil Company

FIRST REPORT Contractor

SE NW

SECTION PLAT

_____ Ft. from N. Line

330 Ft. from S. Line

330 Ft. from E. Line

_____ Ft. from W. Line

		6	

Barton County

Location _____

Rig up _____

Drilling and Remarks:

RECORD

Cased _____ in., _____ ft.

Sand _____

Gas _____

Oil _____

Total Depth _____

PRODUCTION

1st 24 hrs. Nat. _____

1st 24 hrs. after shot _____

Gas _____ Cu. Ft.

Dry Hole _____

Abandoned _____

Date

FEB 23 1949 19

S. J. LEWIS Scout

