


Section 31 Township 30 Range 4 E

Well No. # 4 Donovan

Company E. B. Shawver

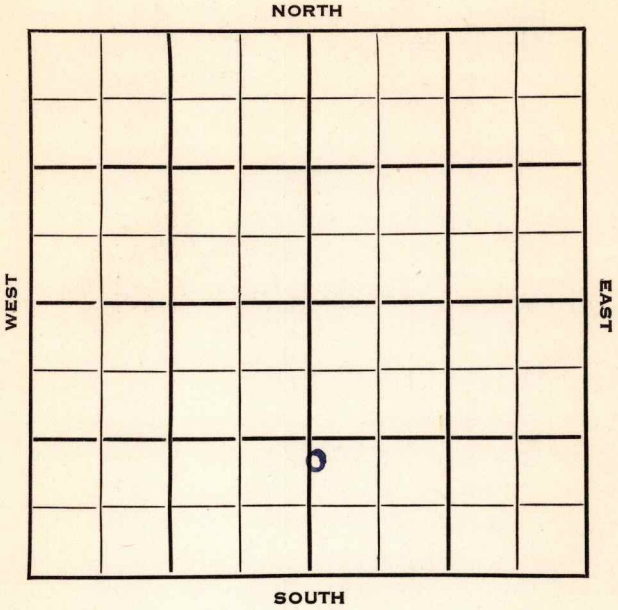

Cowley

KANSAS


 Sec. 31 Twp. 30 R. 4E

 Well No. #4 Donovan Farm

E. B. Shawver Company

Shawver Contractor


 Ft. from N. Line

1126 Ft. from S. Line

 Ft. from E. Line

113 Ft. from W. Line

NW SW SE

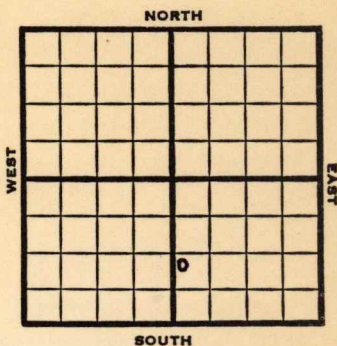

1952

Elev. 1155'

REPORT

12/3

Spud 12-1-52

12/30

Spud 12-1-52 Oil well TD 2860'

8" @ 45 KC 2305' TD 2847'

5" @ 2840' Bart. 2838' TD 2860'

PB 2856' FU 300' oil 12 hr. Hydro.

Comp. 35 BOPD

COMPLETED

County **Cowley** State **Kansas**Sec. **31** (Blk. Twp.) **30** (Sur. Rge.) **4E** Map No.Operator **E. B. Shawver**Well No. **4** Farm **Donovan**Elev. Location **NW SW SE**

FIRST REPORT

o

1126 Ft. From **S** Line **SE****113** Ft. From **W** Line Quarter1st. Report **DEC 3 1952**

Completion

Remarks

Shawver - Contr.Spudding Date **12-1-52**

Drlg. Data

Kansas

(Blk.)
(Twp.)

E. B. Shawver

4 Farm Donovan

1155	Location	NW	SW	SE
------	----------	----	----	----

COMPLETE

1126 Ft. From S Line SE

113 Ft. From W Line Quarter

1st. Report

Completion DEC 30 1952

Remarks

Shawver - Contr.

Spudding Date 12-1-52

Drlg. Data Oil well TD 2860

8" @ 45 KC 2305 TD 2847 5" @ 2840

Bart. 2838 TD 2860 PB 2856

FU 300' oil 12 hr. Hydro.

Comp. 35 bopd

J. G. McGEHEE