
FORM 51 25M 8-50 WESTERN

Barton KANSAS

Section 32 Township 17 Range 11W

Well No. #1 Bortz

Company John Lindas

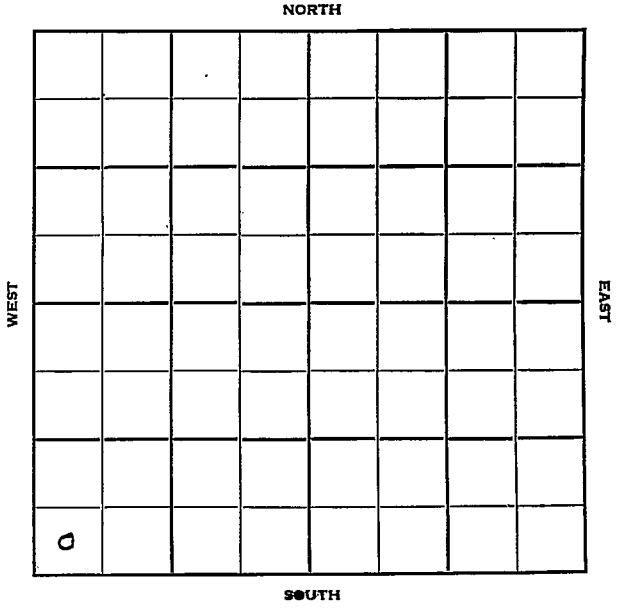

FORM 252-B
10M 10-50 PETROL

Barton KANSAS

Sec. 32 Twp. 17 R. 11W ✓

Well No. #1 Bortz Farm

John Lindas Company

Contractor

Wildcat


Ft. from N. Line

330' Ft. from S. Line

Ft. from E. Line

330' Ft. from W. Line

SW SW SW

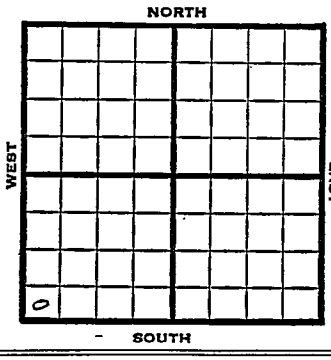


| | |
|---|---|
| 1950 | Elev. 1826' REPORT |
| 12/6 | Spud 11-28-50 |
| 1951 1/3 | Spud 11-28-50<br>D&A TD 3380<br>8" @ 171 Anhy 670' Top. 2643<br>Heeb. 2922 Br. Lime 3045<br>Lans. 3060<br>DST 3161-3232 opn ½ hr<br>Rec. 31' hocm<br>DST 3300-11 opn 1 hr Rec. 60' mud & water Arb. 3367-80 TD<br>SSO 5" @ 3369 24/3228-32<br>16/3224-28 FU 130' water 1/3229 .<br>1/3231 FU 300' fluid 40 min<br>SP 3224 7/3217-23 24/3217-23<br>D&A<br>ABANDONED |

FORM 275 FOR SALE BY KANSAS BLUE PRINT CO.


County Barton State Kansas

Sec. 32 (Blk. Twp.) 17 (Sur. Rge.) 11W Map No.

Operator John Lindas

Well No. 1 Farm Bortz

Elev. 1826 Location SW SW SW

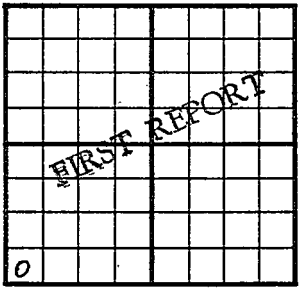


330 Ft. From S Line SW

330 Ft. From W Line Quarter

1st. Report DEC 6 · 1950

Completion

Remarks

Spudding Date 11-28-50

Drlg. Data Wildcat

J. E. TYRA

FORM 275 FOR SALE BY KANSAS BLUE PRINT CO.


County Barton State Kansas

Sec. 32 (Blk. Twp.) 17 (Sur. Rge.) 11W Map No.

Operator John Lindas

Well No. 1 Farm Bortz

Elev. 1826 Location SW SW SW

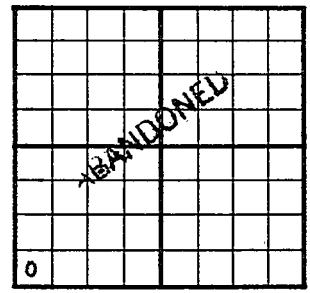


330 Ft. From S Line SW

330 Ft. From W Line Quarter

1st. Report

Completion JAN 3 1951

Remarks Wildcat

Spudding Date 11-28-50

Drlg. Data D &A TD 3380

8" @ 171 Anhy 670 Top. 2643

Heeb. 2922 Br. lime 3045 Lans. 3060

DST 3161-3232 open ½ hr. Rec. 31' hocm

DST 3300-11 open 1 hr. Rec. 60' mud &

water Arb. 3367-80 TD SSO 5" @ 3369

24/ 3228-32 - 16/ 3224-28 FU 130' water

1/ 3229 1/ 3231 FU 300' fluid 40 min.

SP 3224 7/ 3217-23 24/ 3217-23

D & A

J. E. TYRA