


Section 35 Township 17 Range 11 W

Well No. # 1 Morgan

Company Aylward Drlg.

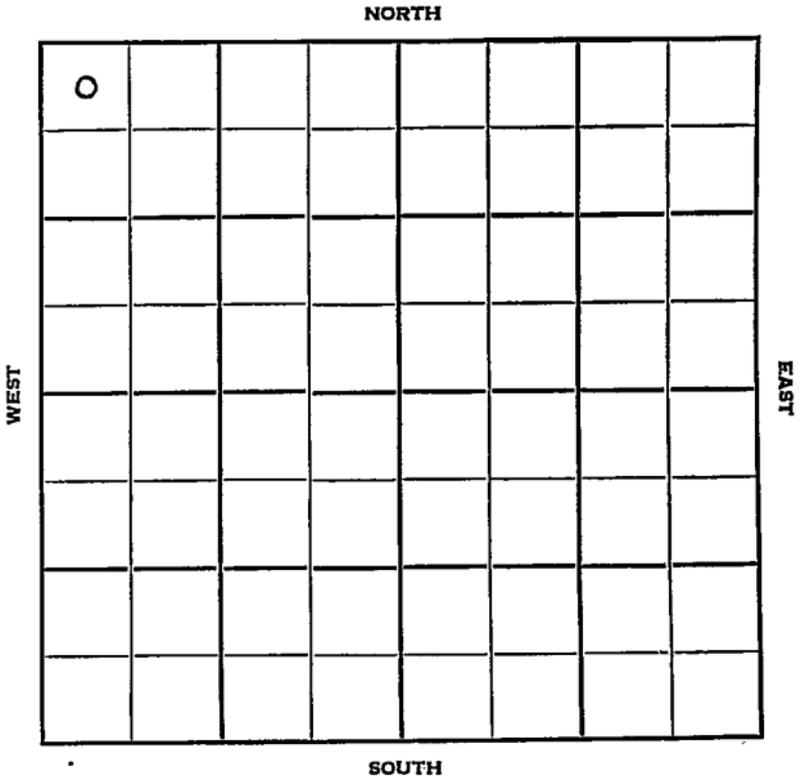

Barton

KANSAS

Sec. 35 Twp. 17 R. 11 W

Well No. # 1 Morgan Farm

Aylward Drlg. Company

B & B Drlg. Contractor

Kraft-Prusa Pool


330 Ft. from N. Line

\_\_\_\_\_ Ft. from S. Line

\_\_\_\_\_ Ft. from E. Line

330 Ft. from W. Line

NW NW NW

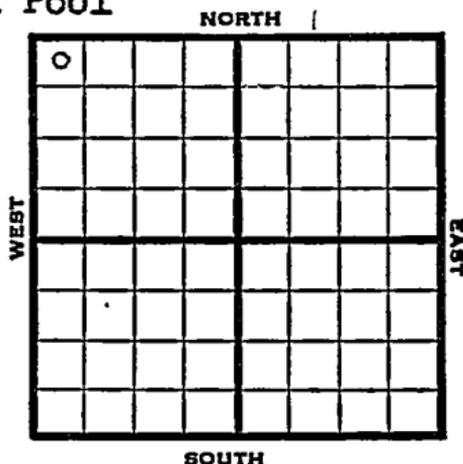

1951

Elev. 1836'

REPORT

5/2

Spud 4-29-51  
8" @ 180  
Drlg. 200'

5/16

Spud 4-29-51  
D & A TD 3333' 8" @ 180  
Heeb. 2908' Br. line 3017'  
Lans. 3029' Cong 3309' TD 3333'  
D & A

ABANDONED

County Barton State Kansas

Sec. 35 (Blk. 17) (Sur. Rge.) 11W Map No. 1

Operator Aylward Drlg.

Well No. 1 Farm Morgan

Elev. \_\_\_\_\_ Location NW NW NW

0					

330 Ft. From N Line NW

330 Ft. From W Line Quarter

Ist. Report MAY 2 1951

Completion. \_\_\_\_\_

Remarks \_\_\_\_\_

B & B Drlg. - Contr.

Spudding Date 4-29-51

Drlg. Data Kraft-Prusa Pool

8" @ 180 drlg. 200

County Barton State Kansas

Sec. 35 (Blk. 17) (Sur. 11W) (Twp.) (Rge.) Map No.

Operator Aylward Drlg.

Well No. 1 Farm Morgan

Elev. 1836 Location NW NW NW

o					

330 Ft. From N Line NW

330 Ft. From W Line Quarter

1st. Report

Completion MAY 16 1951

Remarks Kraft-Prusa Pool

B & B Drlg. - Contr.

Spudding Date 4-29-51

Drlg. Data D & A TD 3333

8" @ 180 Heeb. 2908 Br. lime 3017

Lans. 3029 Cong. 3309 TD 3333

D & A

J. E. TYRA