


Section 28 Township 17 Range 11W

Well No. 1 Soeken

Company R. L. Williams et al
Kraft-Prusa

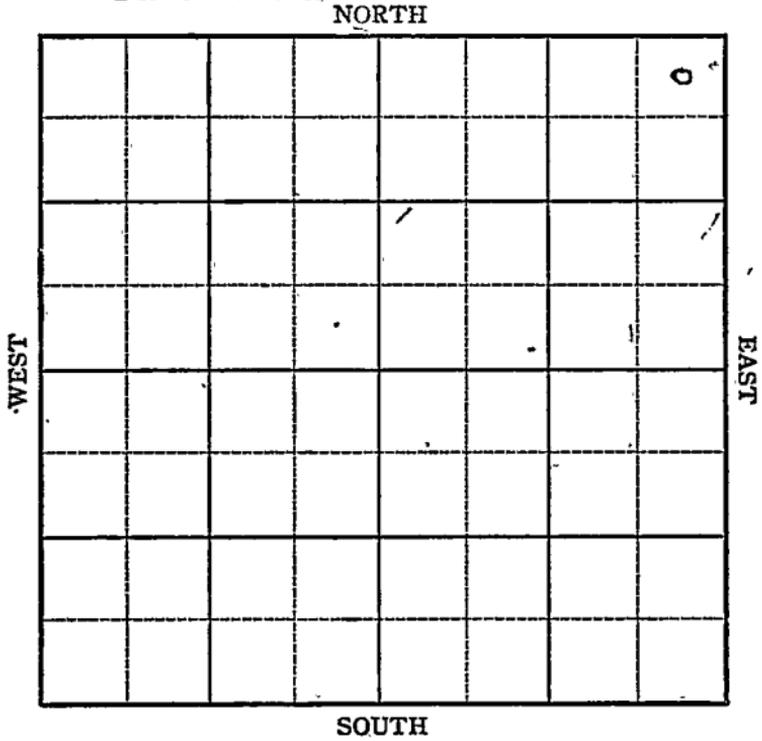

Sec. 28 Twp. 17 R. 11W ✓

Well No. #1 Soeken Farm

R. L. Williams et al Company

Kraft-Prusa


330 Ft. from N. Line

_____ Ft. from S. Line

330 Ft. from E. Line

_____ Ft. from W. Line

KNE/C

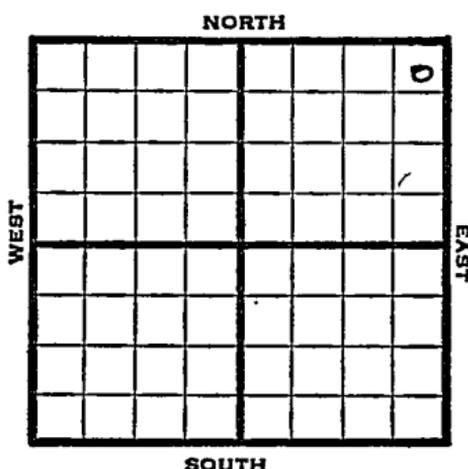

1947

Elev. 1828

REPORT

- 4/2 8" @ 260'
WOC
- 4/9 Drlg 2676'
- 4/15 Lansing 3013'
Arbuckle 3286-90' TD
5" @ 3287'
RUST
- 4/23 " "
- 4/29 " "
- 5/7 " "
- 5/13 TD 3290'
- 5/21 " "
- 5/28 Lans 3013
Arb 3286
5" @ 3287
Perf Lans
1000 Acid water
TD 3305'

ABANDONED

Map No. K55 Sec. 28 Twp. 17 R. 11W

Well No. 1 Soeken

R. L. Williams et al. Company

FIRST REPORT Contractor

NE/C


SECTION PLAT

330 Ft. from N. Line

 Ft. from S. Line

330 Ft. from E. Line

 Ft. from W. Line

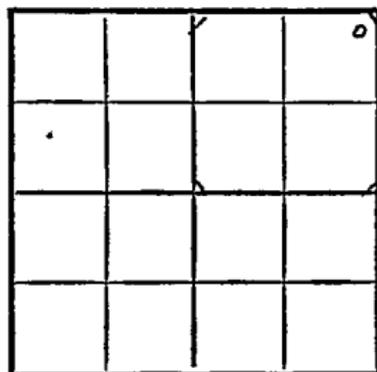

Barton County

Location

Rig up

Drilling and Remarks:

8" @ 260 WOC*

RECORD

Cased in., ft.

Sand

Gas

Oil

Total Depth

PRODUCTION

1st 24 hrs. Nat.

1st 24 hrs. after shot

Gas ' Cu. Ft.

Dry Hole

Abandoned

Date

APR 2 1947 19

S. J. LEWIS Scout

Kansas

KANSAS

Kraft-Prusa

Map No. K 55 Sec. 28 Twp. 17 R. 11W

Well No. 1 Soeken

R. L. Williams et al. Company

ABANDONED

Contractor

NE/C

E. 11828

SECTION PLAT

330 Ft. from N. Line

_____ Ft. from S. Line

330 Ft. from E. Line

_____ Ft. from W. Line

			4

Barton County

Location _____

Rig up _____

Drilling and Remarks:

Lane 3013
Ar 43286
5' 03287
Prof Lane.
10 acid water

RECORD

Cased _____ in., _____ ft.

Sand _____

Gas _____

Oil _____

Total Depth 3805

PRODUCTION

1st 24 hrs. Nat. _____

1st 24 hrs. after shot [?] _____

Gas _____ Cu. Ft.

Dry Hole _____

Abandoned _____

Date _____

MAY 28 1947 19

S. J. LEWIS Scout