


Map No. _____ Sec. 31 Twp. 30 R. 4

Well No. 1 Donovan Farm
Benedum & Trees Company

NORTH

(Donovan)

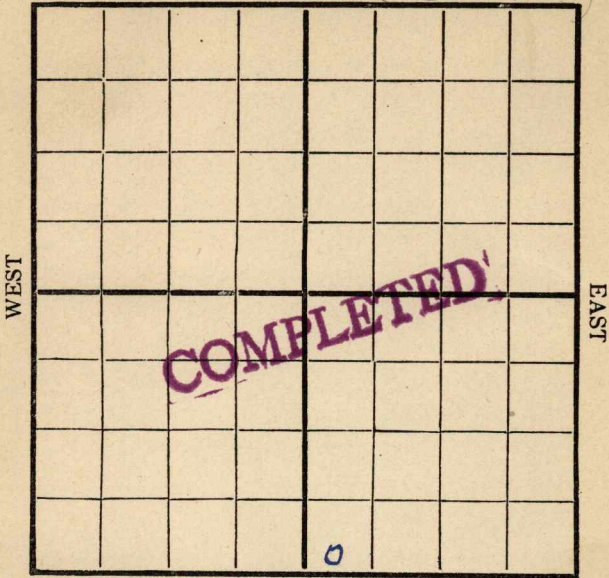

SOUTH

Location 6/20

Rig Up _____

Drilling Remarks:

Drilling Remarks:

9/30 - 980 - 21 R
10/14 - 1040 -
10/21 - 1340 - F
10/28 - 1605
11/4 - 1730
11/18 - 2150
11/25 - 2425
12/2 - 2515
12/9 - 2625
12/23 - 2630
12/30 - 2892 F
1/6 - 2930
1/13 - 3110
1/20 - 3220

RECORD


PRODUCTION

Cased _____ in _____ Ft.
 Sand _____
 Gas _____
 Oil _____
 Total Depth _____

1st 24 hrs. Nat. _____
 1st 24 hrs. after shot _____
 Gas _____ Cu. Ft.
 Dry Hole _____
 Abandoned _____

Map No. _____ Sec. 31 Twp. 30 R. 4
 Well No. 1 Doneman Farm
Benedum & Trees Company

NORTH

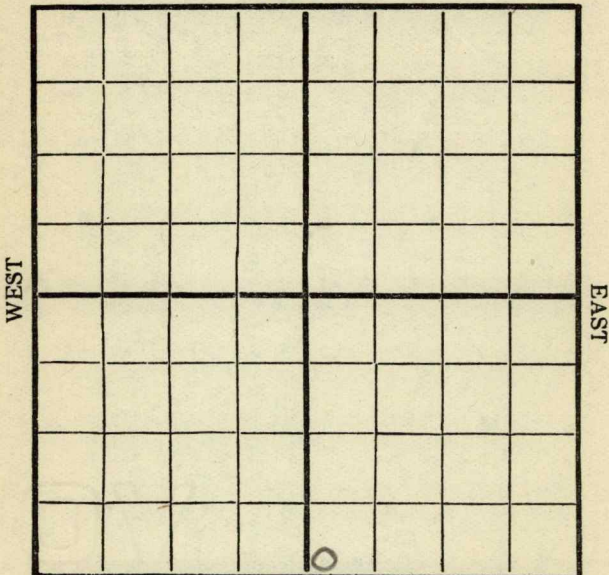

SOUTH

Location 6/29
 Rig Up ✓
 Drilling and remarks

RECORD

Cased _____ in. _____ Ft.
 Sand _____
 Gas _____
 Oil _____
 Total Depth _____

PRODUCTION


1st 24 hrs. Nat. _____
 1st 24 hrs. after shot _____
 Gas _____ Cu. Ft.
 Dry Hole _____
 Abandoned _____

Date

7/22, 1916 H. Farnsworth Scout

Map No. _____ Sec. 31 Twp. 30 R. 4
Well No. 1 Doneman Farm
Benedum & Trus Company

NORTH

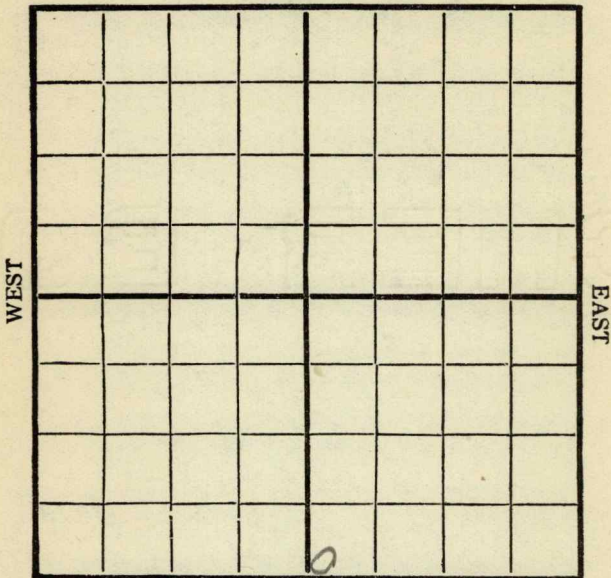

SOUTH

Location _____
Rig Up _____
Drilling and remarks _____

RECORD

Cased _____ in. _____ Ft.
Sand _____
Gas _____
Oil _____
Total Depth _____

PRODUCTION


1st 24 hrs. Nat. _____
First 24 h. s. after shot _____
Gas _____ Cu. Ft.
Dry Hole _____
Abandoned _____

Date

7/30, 1916 H. Farnsworth Scout

Map No. _____ Sec. 31 Twp. 30 R. 4
 Well No. Doneman Farm
Benedict Trust Company

NORTH

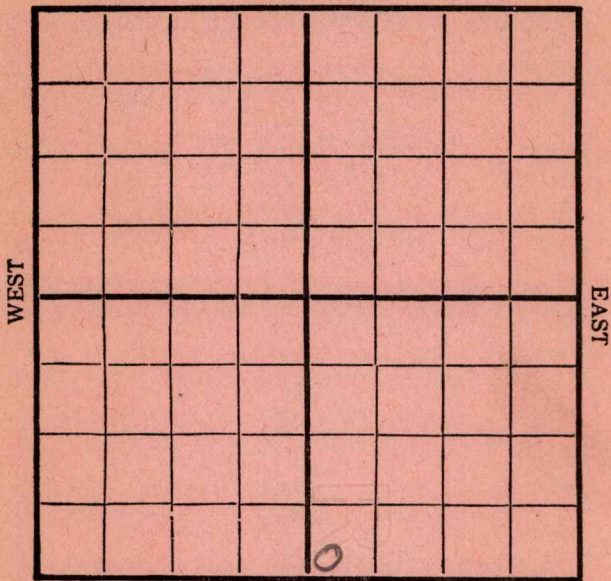


SOUTH

| | |
|----------------------|---------------------------------|
| | RECORD |
| Location _____ | Cased _____ in. _____ Ft. |
| Rig Up _____ | Sand _____ |
| Drilling and remarks | Gas _____ |
| <u>Took moved</u> | Oil _____ |
| <u>in.</u> | Total Depth _____ |
| | |
| | PRODUCTION |
| | 1st 24 hrs. Nat. _____ |
| | First 24 h. s. after shot _____ |
| | Gas _____ Cu. Ft. |
| | Dry Hole _____ |
| | Abandoned _____ |

Date 8/14, 1916 H. Farns Scout

Map No. _____ Sec. 31 Twp. 30 R. 4
Well No. J. Doremus Farm
Benedum Trees Company

NORTH

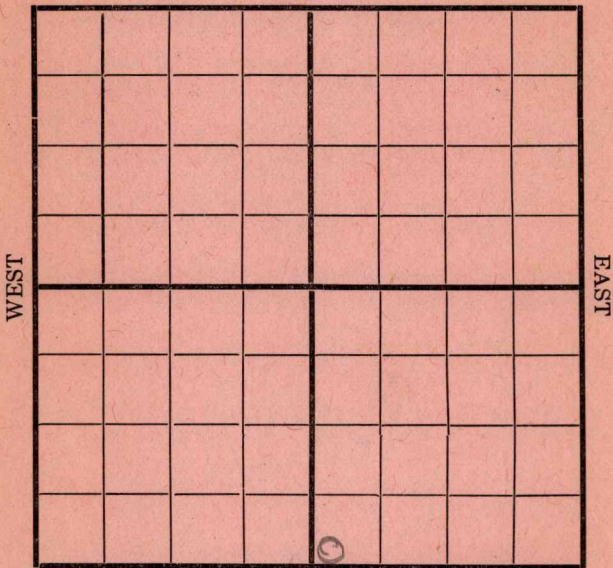

SOUTH

Location _____
 Rig Up _____
 Drilling and remarks
Tools moved
u.

RECORD

Cased _____ in. _____ Ft.
 Sand _____
 Gas _____
 Oil _____
 Total Depth _____

PRODUCTION

1st 24 hrs. Nat. _____
 1st 24 hrs. after shot _____
 Gas _____ Cu. Ft.
 Dry Hole _____
 Abandoned _____

Date 8/19, 1916 H. T. Jones Scout


Cowley

Map No. _____ Sec. *31* Twp. *30* R. *4*

Well No. *1* *Doneman* Farm

_____ *Benedum & Trees* Company

NORTH

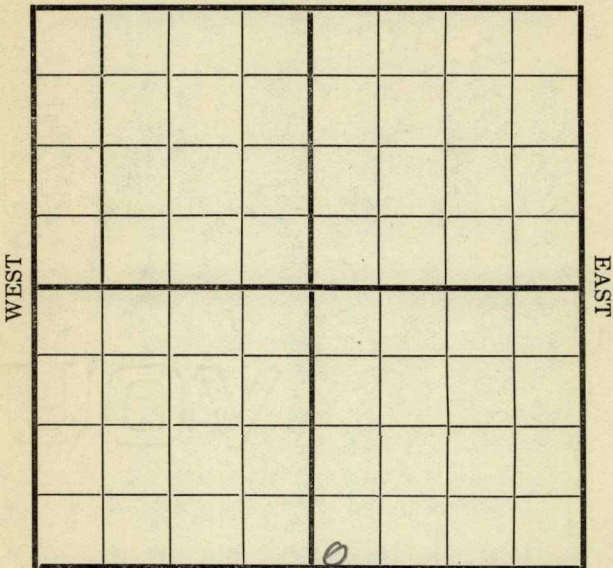

SOUTH

Location _____

Rig Up _____

Drilling and remarks

Rigging up

RECORD

Cased _____ in. _____ Ft.

Sand _____

Gas _____

Oil _____

Total Depth _____

PRODUCTION

1st 24 hrs. Nat. _____

1st 24 hrs. after shot _____

Gas _____ Cu. Ft.

Dry Hole _____

Abandoned _____

Date

8/26, 191 *6*

E. Hunt Scout

Cowley


Map No. _____ Sec. 31 Twp. 30 R. 4

Well No. 1 Doneman Farm
Benedum & Trees Company

NORTH

WEST

EAST

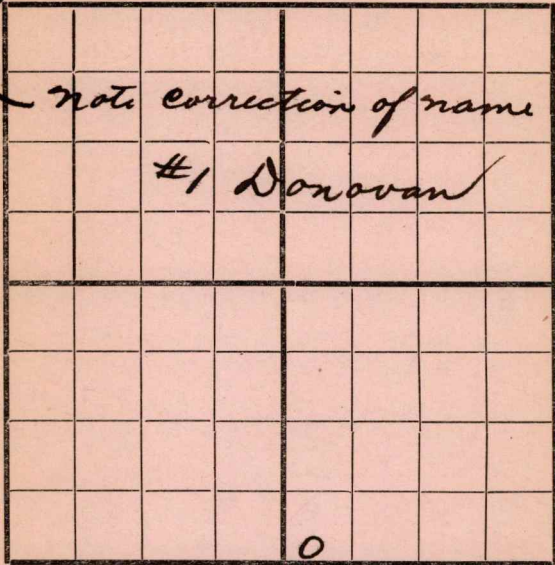

SOUTH

Location _____

Rig Up _____

Drilling and remarks

285

RECORD

Cased _____ in. _____ Ft.

Sand _____

Gas _____

Oil _____

Total Depth _____

PRODUCTION

1st 24 hrs. Nat. _____

1st 24 hrs. after shot _____

Gas _____ Cu. Ft.

Dry Hole _____


Abandoned _____

Date 9/2, 1916

Exwert Scout

Cawley
Map No. _____ Sec. *31* Twp. *30* R. *4*
Well No. *1 Donovan* Farm
Benedum & Trees Company

NORTH

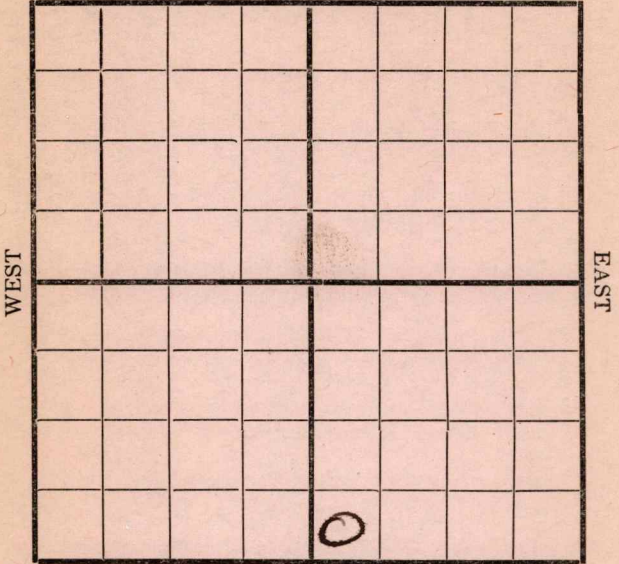

SOUTH

Location _____

Rig Up _____

Drilling and remarks

✓
500

RECORD

Cased _____ in. _____ Ft.

Sand _____

Gas _____

Oil _____

Total Depth _____

PRODUCTION

1st 24 hrs. Nat. _____

1st 24 hrs. after shot _____

Gas _____ Cu. Ft.

Dry Hole _____

Abandoned _____

Date

9/9, 191 *6*


Efferson Scout

Cowley

Map No. _____ Sec. *31* Twp. *30* R. *4*

Well No. *1 Donovan* Farm _____
Ohio Oil Company _____

NORTH

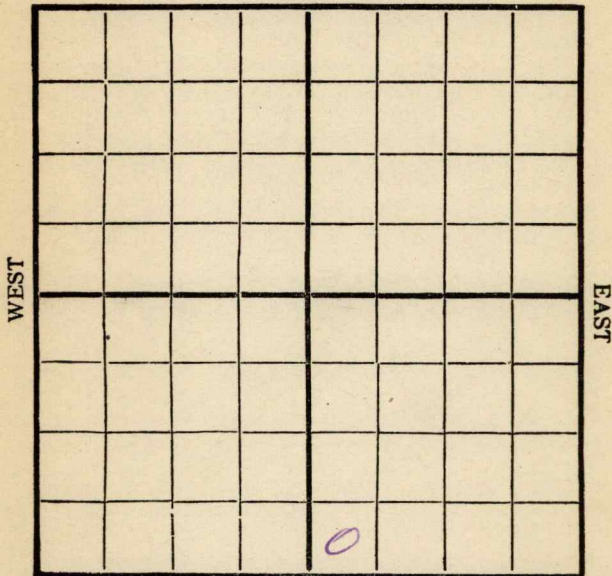

SOUTH

Location _____
 Rig Up _____
 Drilling and remarks
S.D. 980
waiting for
underreamer

RECORD

Cased _____ in. _____ Ft.
 Sand _____
 Gas _____
 Oil _____
 Total Depth _____

PRODUCTION

1st 24 hrs. Nat. _____
 First 24 hrs. after shot _____
 Gas _____ Cu. Ft.
 Dry Hole _____
 Abandoned _____

Date *9/23*, 191*6*

E. Everett Scout

Cowley

Map No. _____ Sec. *31* Twp. *30* R. *4*


Well No. *1 Donovan* Farm

Ohio Oil Company

NORTH

WEST

EAST

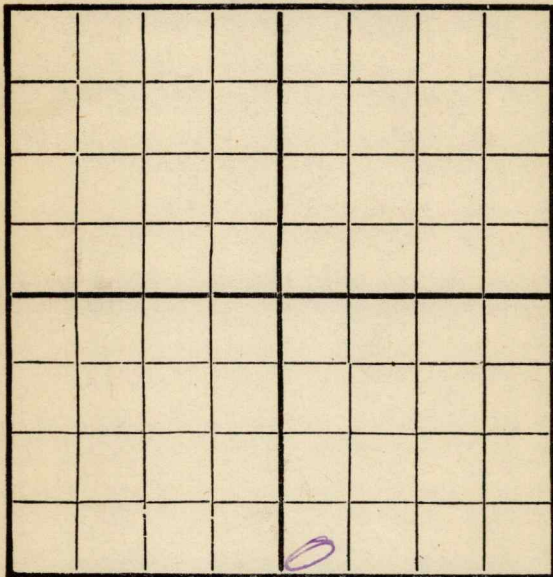

SOUTH

Location _____

Rig Up _____

Drilling and remarks

U.R. 985

RECORD

Cased _____ in. _____ Ft.

Sand _____

Gas _____

Oil _____

Total Depth _____

PRODUCTION

1st 24 hrs. Nat. _____

First 24 hrs. after shot _____

Gas _____ Cu. Ft.

Dry Hole _____

Abandoned _____

Date

9/30


191 *6*

W. West

Scout

Map No. Cowley Sec. 31 Twp. 30 R 4
Well No. 1 Donovan Farm
Benedum & Trees Company

NORTH

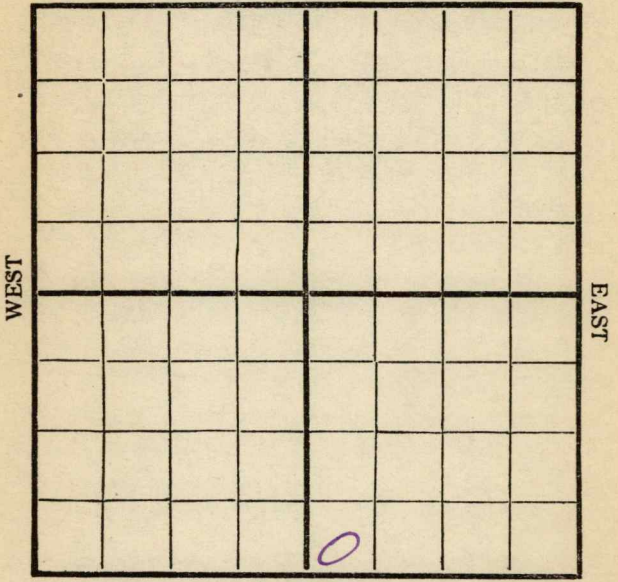

SOUTH

Location -----
Rig Up -----
Drilling and remarks
UR at 980

RECORD

Cased ----- in. ----- Ft.
Sand -----
Gas -----
Oil -----
Total Depth -----

PRODUCTION

1st 24 hrs. Nat. -----
1st 24 hrs. after shot -----
Gas ----- Cu. Ft.
Dry Hole -----
Abandoned -----


Date 10/7, 1916 E. H. West Scout

Map No. Cowley Sec. 31 Twp. 30 R. 4
Well No. 1 Donovan Farm
Benedict & Trees Company

NORTH

WEST

EAST

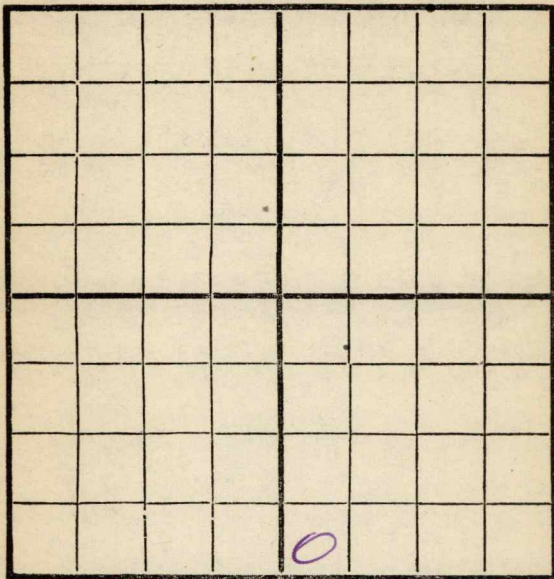

SOUTH

Location _____
Rig Up _____
Drilling and remarks _____

✓
1040

RECORD

Cased _____ in. _____ Ft.
Sand _____
Gas _____
Oil _____
Total Depth _____

PRODUCTION

1st 24 hrs. Nat. _____
First 24 hrs. after shot _____
Gas _____ Cu. Ft.
Dry Hole _____
Abandoned _____

Date 10/14, 1916

E. West Scout

COWLEY

Map No. _____ Sec. 31 Twp. 30 R. 4


Well No. 1 Donovan Farm _____

_____ Benedum & Trees Company

NORTH

WEST

EAST

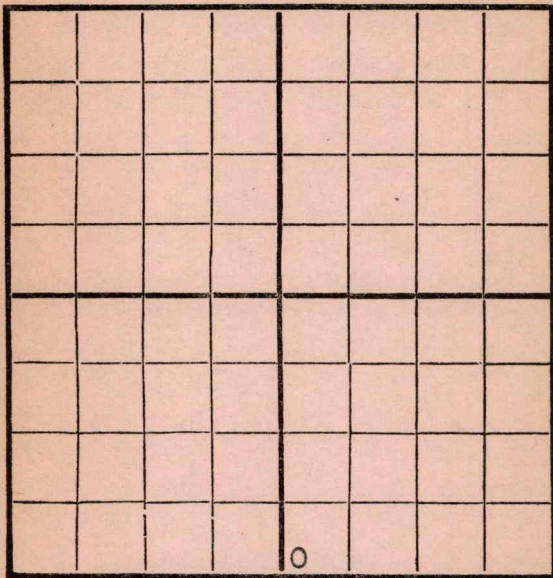

SOUTH

RECORD

Location _____
Rig Up _____
Drilling and remarks _____

Cased _____ in. _____ Ft.
Sand _____
Gas _____
Oil _____
Total Depth _____

Fishing 1340

PRODUCTION

1st 24 hrs. Nat. _____
First 24 hrs. after shot _____
Gas _____ Cu. Ft.
Dry Hole _____
Abandoned _____

Date

OCT 21 1918

191

E. H. WEST

Scout


COWLEY

Map No. _____ Sec. 31 Twp. 30 R. 4

Well No. 1 Donovan Farm _____

_____ Benedum & Trees Company

NORTH

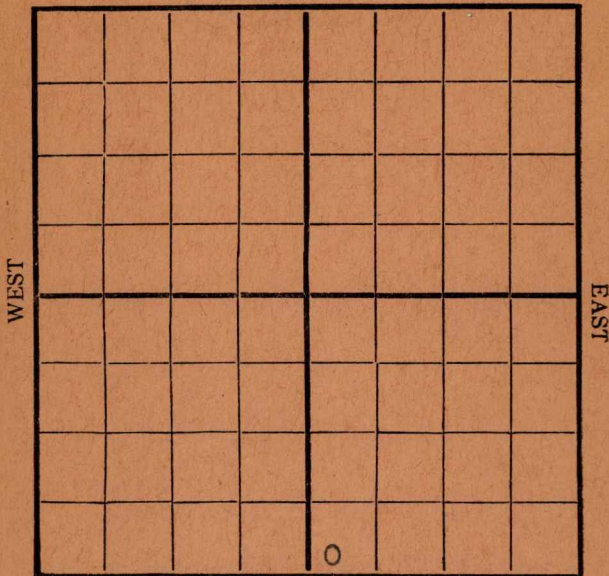

SOUTH

Location _____

Rig Up _____

Drilling and remarks

1605

RECORD

Cased _____ in. _____ Ft.

Sand _____

Gas _____

Oil _____

Total Depth _____

PRODUCTION

1st 24 hrs. Nat. _____

1st 24 hrs. after shot _____

Gas _____ Cu. Ft.

Dry Hole _____

Abandoned _____

Date

OCT 28 1916

191


E. H. WEST

Scout

Map No. Cowley Sec. 31 Twp. 30 R. 4

Well No. 1 Donovan Farm
Benedum & Trees Company

NORTH

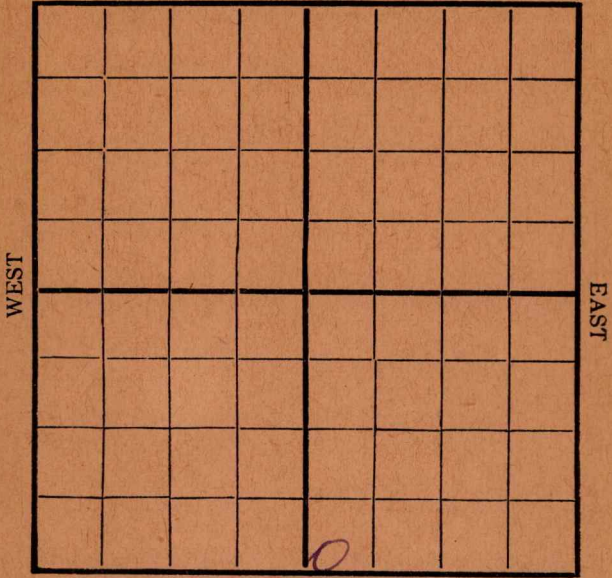

SOUTH

Location

Rig Up

Drilling and remarks

✓
1730

RECORD

Cased in. Ft.

Sand

Gas

Oil

Total Depth

PRODUCTION

1st 24 hrs. Nat.

1st 24 hrs. after shot

Gas Cu. Ft.

Dry Hole

Abandoned

Date

11/4, 1916,

E. H. WEST

Scout


COWLEY

Map No. Sec. **31** Twp. **30** R. **4**

Well No. **1** **Donovan** Farm

Benedum & Trees Company

NORTH

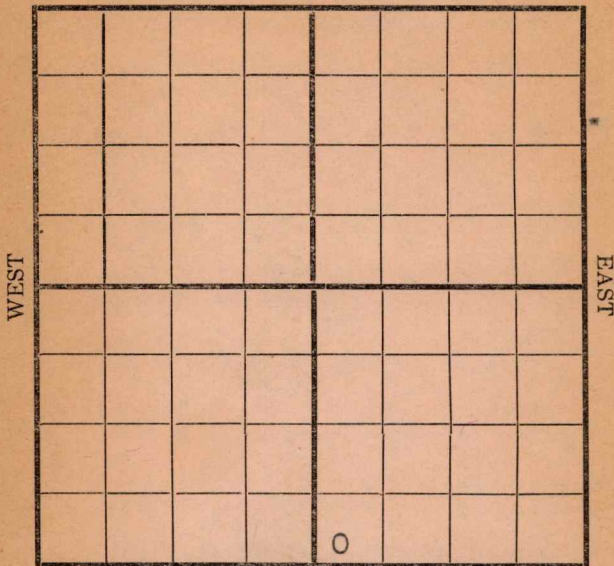

SOUTH

Location

Rig Up

Drilling and remarks

/ 2150

RECORD

Cased in. Ft.

Sand

Gas

Oil

Total Depth

PRODUCTION

1st 24 hrs. Nat.

1st 24 hrs. after shot

Gas Cu. Ft.

Dry Hole

Abandoned

Date

NOV 18 1916

191

E. H. WEST


Scout

COWLEY

Map No. _____ Sec. 31 Twp. 30 R. 4

Well No. 1 Donovan Farm
_____ Benedum & Trees Company

NORTH

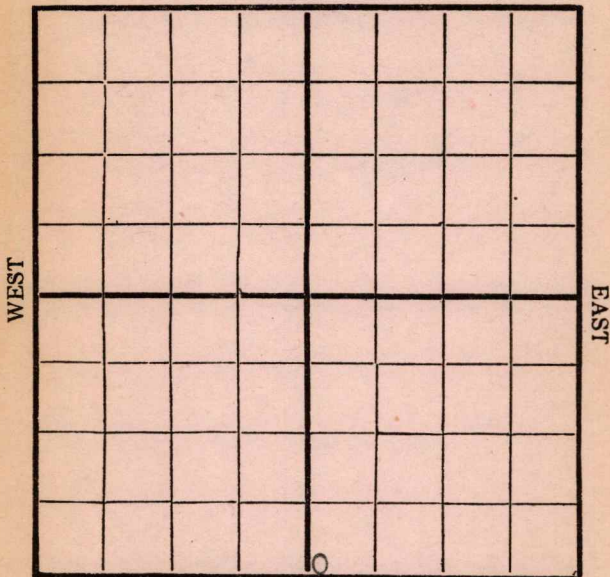

SOUTH

Location _____

Rig Up _____

Drilling and remarks

/ 2100

RECORD

Cased _____ in. _____ Ft.

Sand _____

Gas _____

Oil _____

Total Depth _____

PRODUCTION

1st 24 hrs. Nat. _____

1st 24 hrs. after shot _____

Gas _____ Cu. Ft.

Dry Hole _____

Abandoned _____

Date

NOV 11 1916

191 _____

E. H. WEST Scout


COWLEY

Map No. Sec. **31** Twp. **30** R. **4**

Well No. **1** **Donovan** Farm

..... **Benedum & Trees** Company

NORTH

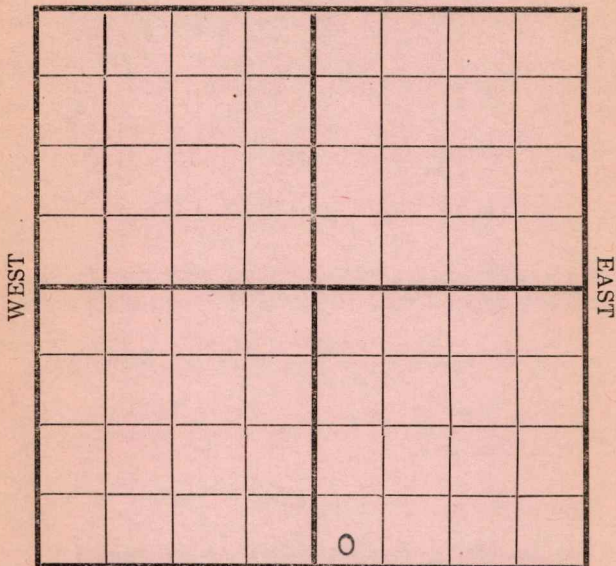

SOUTH

Location

Rig Up

Drilling and remarks

2425

RECORD

Cased in. Ft.

Sand

Gas

Oil

Total Depth

PRODUCTION

1st 24 hrs. Nat.

1st 24 hrs. after shot

Gas Cu. Ft.

Dry Hole

Abandoned

Date

NOV 25 1916

191

E. H. WEST

Scout


COWLEY

Map No. _____ Sec. 31 Twp. 30 R. 4

Well No. 1 Donovan Farm

Benedum & Trees Company

NORTH

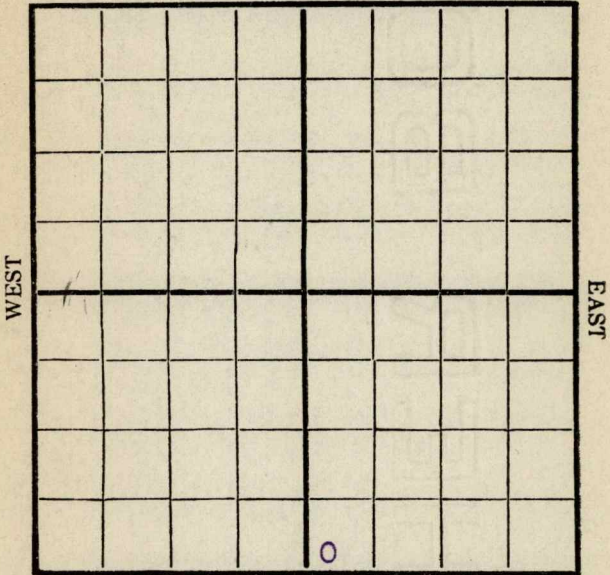

SOUTH

Location _____

Rig Up _____

Drilling and remarks

2515 H.F. Water

RECORD

Cased _____ in. _____ Ft.

Sand _____

Gas _____

Oil _____

Total Depth _____

PRODUCTION

1st 24 hrs. Nat. _____

1st 24 hrs. after shot _____

Gas _____ Cu. Ft.

Dry Hole _____

Abandoned _____

Date

DEC - 2 1916

E. H. WEST


191

Scout

COWLEY

Map No. _____ Sec. 31 Twp. 30 R. 4
 Well No. 1 Donovan Farm _____
B + J Company _____

NORTH

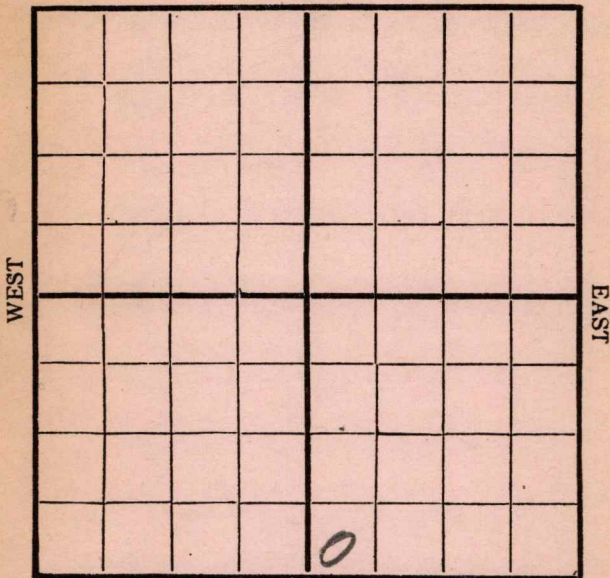

SOUTH

Location _____

Rig Up _____

Drilling and remarks

SD-2625

RECORD

Cased _____ in. _____ Ft.

Sand _____

Gas _____

Oil _____

Total Depth _____

PRODUCTION

1st 24 hrs. Nat. _____

1st 24 hrs. after shot _____

Gas _____ Cu. Ft.

Dry Hole _____

Abandoned _____

Date

WEG - 9 1916

191


E. H. WEST Scout

COWLEY

Map No. _____ Sec. 31 Twp. 30 R. 4

Well No. 1 Donovan Farm _____
 _____ B+J Company _____

NORTH

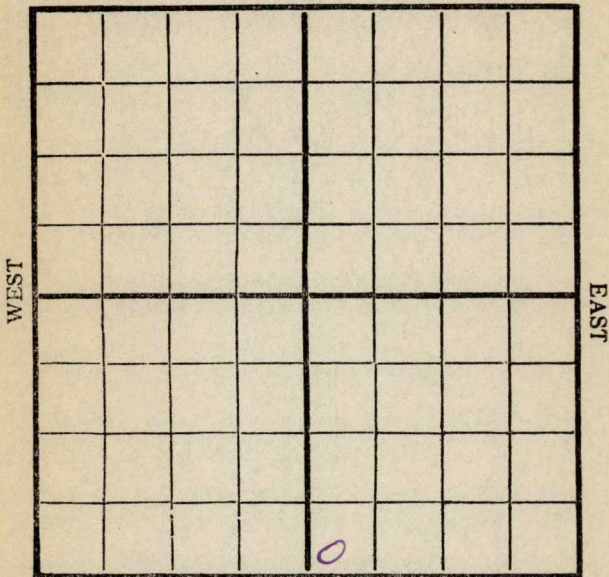

SOUTH

Location _____

Rig Up _____

Drilling and remarks

SD-2625
for cable

RECORD

Cased _____ in. _____ Ft.

Sand _____

Gas _____

Oil _____

Total Depth _____

PRODUCTION

1st 24 hrs. Nat. _____

1st 24 hrs. after shot _____

Gas _____ Cu. Ft.

Dry Hole _____

Abandoned _____

Date

DEC 16 1916

E. H. WEST

Scout


COWLEY

Map No. _____ Sec. 31 Twp. 30 R. 4

Well No. 1 Donovan Farm _____

_____ B+J Company _____

NORTH

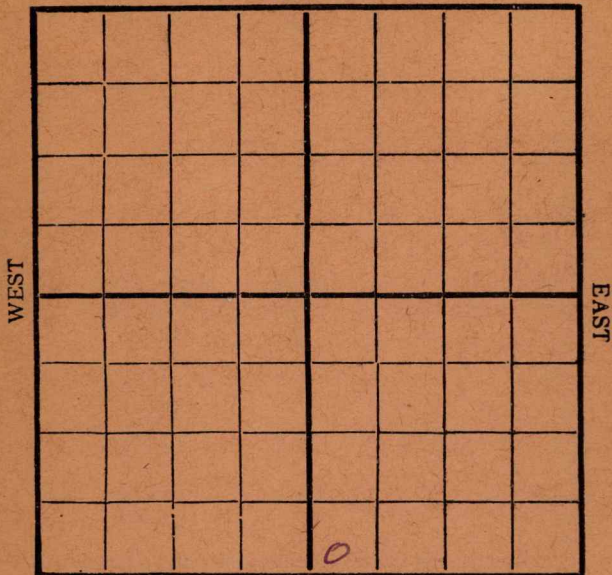

SOUTH

Location _____

Rig Up _____

Drilling and remarks

S.D. 2630

over Xmas

expect top of
Clarke sand at 2830

RECORD

Cased _____ in. _____ Ft.

Sand _____

Gas _____

Oil _____

Total Depth _____

PRODUCTION

1st 24 hrs. Nat. _____

1st 24 hrs. after shot _____

Gas _____ Cu. Ft.

Dry Hole _____

Abandoned _____

Date

DEC 23 1916

191

E. H. WEST

Scout


COWLEY

Map No. _____ Sec. 31 Twp. 30 R. 4

Well No. 1 Donovan Farm _____

_____ Company _____

NORTH

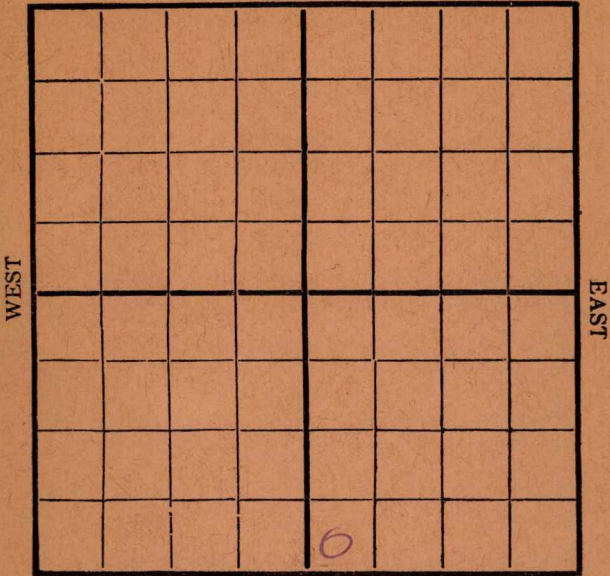

SOUTH

Location _____

Rig Up _____

Drilling and remarks

Fishing 2892

This well will be carried to about 3350

RECORD

Cased _____ in. _____ Ft.

Sand 2841 - 42

Gas _____

Oil Rainbow show

Total Depth _____

PRODUCTION

1st 24 hrs. Nat. _____

1st 24 hrs. after shot _____

Gas _____ Cu. Ft.

Dry Hole _____

Abandoned _____

Date

DEC 30 1916

E. H. WEST

191

Scout


COWLEY

Map No. _____ Sec. 31 Twp. 30 R. 4

Well No. 1 Donovan Farm _____

_____ B + J Company

NORTH

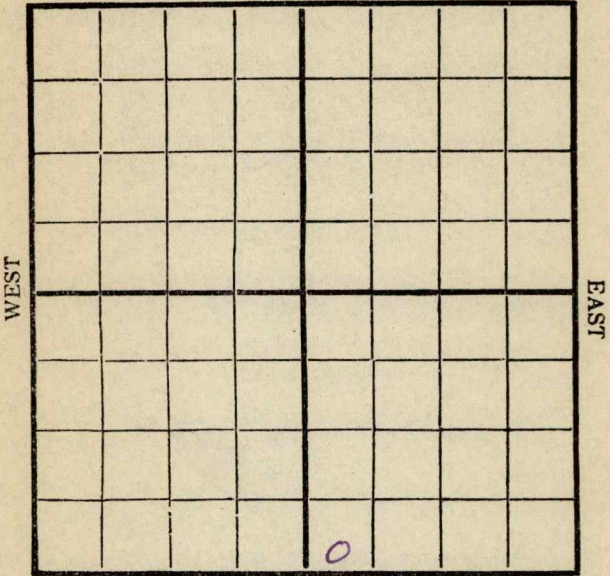

SOUTH

Location _____

Rig Up _____

Drilling and remarks

2930

RECORD

Cased _____ in. _____ Ft.

Sand _____

Gas _____

Oil _____

Total Depth _____

PRODUCTION

1st 24 hrs. Nat. _____

1st 24 hrs. after shot _____

Gas _____ Cu. Ft.

Dry Hole _____

Abandoned _____

Date

JAN - 6 1917


191

E. H. WEST

Scout

COWLEY
 Map No. _____ Sec. 31 Twp. 30 R. 4
 Well No. 1 Donovan Farm _____
B + J Company _____

NORTH

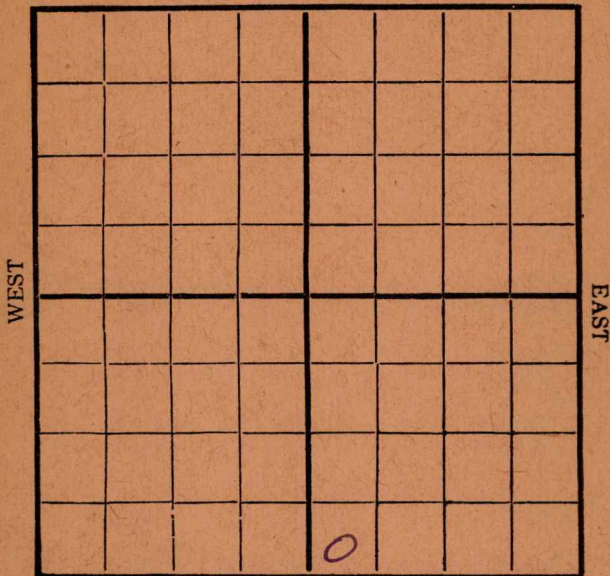

SOUTH

Location _____
 Rig Up _____
 Drilling and remarks

✓ 3110

RECORD

Cased _____ in. _____ Ft.
 Sand _____
 Gas _____
 Oil _____
 Total Depth _____

PRODUCTION

1st 24 hrs. Nat. _____
 1st 24 hrs. after shot _____
 Gas _____ Cu. Ft.
 Dry Hole _____
 Abandoned _____

Date

JAN 13 1917

E. H. WEST

, 191


Scout

COWLEY

Map No. _____ Sec. 31 Twp. 30 R. 4

Well No. 1 Donovan Farm _____
B + J Company _____

NORTH

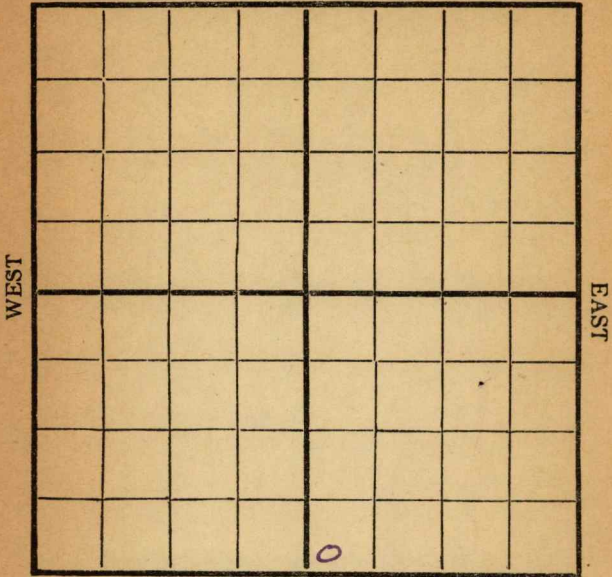

SOUTH

Location _____

Rig Up _____

Drilling and remarks

3220

RECORD

Cased _____ in. _____ Ft.

Sand _____

Gas _____

Oil _____

Total Depth _____

PRODUCTION

1st 24 hrs. Nat. _____

1st 24 hrs. after shot _____

Gas _____ Cu. Ft.

Dry Hole _____

Abandoned _____

Date

JAN 20 1917

E. H. WEST

191

Scout

Map No. ~~KH~~ Sec. 31 Twp. 30 R. 4

Well No. J. Donovan


Company

Contractor

NORTH

WEST

EAST

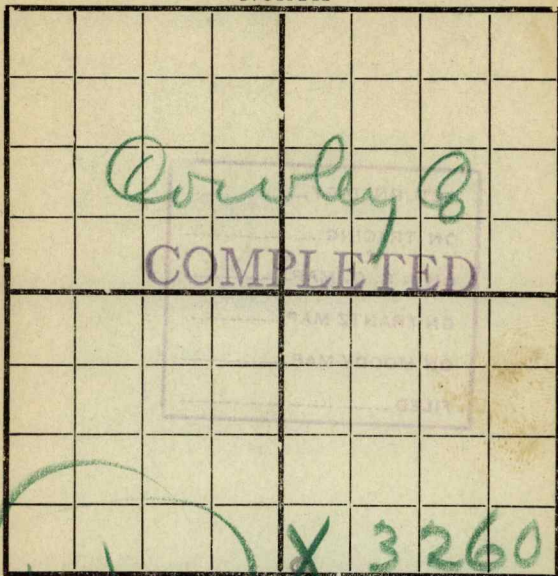

SOUTH

1/24/17

Location

Rig up

Drilling and Remarks:

RECORD

Cased.....in.,ft.

Sand.....

Gas.....

Oil.....

Total Depth.....

PRODUCTION

1st 24 hrs. Nat.

1st 24 hrs. after shot.....

Gas.....Cu. Ft.

Dry Hole.....

Abandoned.....

3220
Dry abundant
3260

Date

1/20

191

CH West

Scout

Cowley

MAP NO. *K11* **KANSAS** SEC. *31* TWP. *30S* R. *4E*

WELL NO. *1* *Borvon*
Benedum & Sons COMPANY

CONTRACTOR

ABANDONED

SECTION PLAT

| | | | |
|--|--|---|--|
| | | | |
| | | | |
| | | | |
| | | | |
| | | 0 | |

_____ FT. FROM N. LINE
 _____ FT. FROM S. LINE
 _____ FT. FROM E. LINE
 _____ FT. FROM W. LINE

no known

LOCATION _____

RIG UP _____

DRILLING AND REMARKS:

RECORD

CASED _____ IN. _____ FT.
 SAND _____
 GAS _____
 OIL _____
 TOTAL DEPTH *3262*

PRODUCTION

1ST 24 HRS. NAT. _____
 1ST 24 HRS. AFTER SHOT _____
 GAS _____ CU. FT.
 DRY HOLE *-*
 ABANDONED *-*

DATE *Jan 23* 19*17*

SCOUT