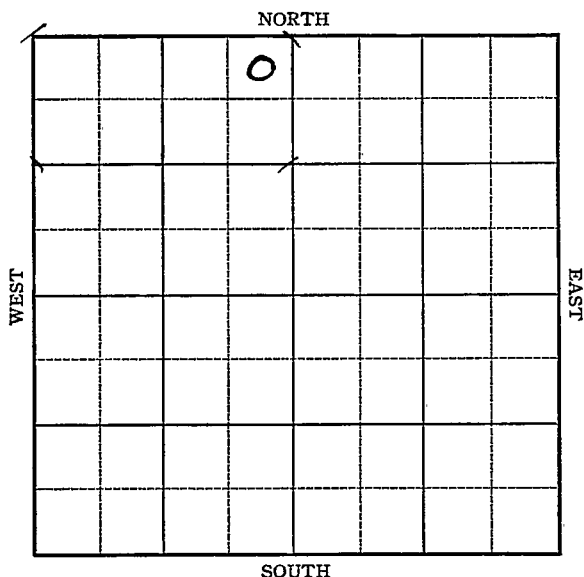



Barton

KANSAS

Section 33 Township 17 Range 11-WWell No. 1 - NorrisCompany Arch Merriman

Sec. 33 Twp. 17 R. 11-WWell No. #1 Norris FarmArch Merriman Company330 Ft. from N. Line Ft. from S. Line330 Ft. from E. Line Ft. from W. Line

Elev. 1813

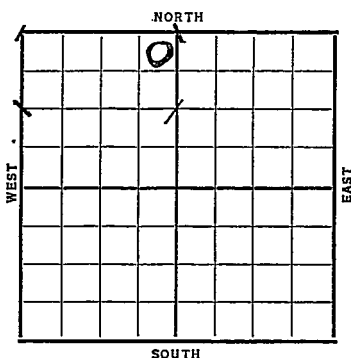


Date	REPORT <i>Special</i>
1937	
9/15	Location
9/24	Rig cable.
10/2	R. U.
10/9	15" @ 195'. T.D. 330'.
	Rng. 12".
10/15	Shut down 330'.
10/22	T.D. 360' SD.
10/29	Anhy 620'. Drl g. 850'.
11/5	12" @ 640'. Drl g. 1945'.
11/12	10" @ 2021'. Topeka 2635'.
	T.D. 2650'. Rng. 8".
11/19	8" @ 2650'. K.C. 3030'.
	Drl g. 3075'.
11/26	T.D. 3240'. 6" @ 3234'. C.O.
12/1	6" @ 3234'.
	Sil. 3345'.
	T.D. 3354'.
	H.F.W.
	ABANDONED

Barton KANSAS

Map No. _____ Sec. 33 Twp. 17 R. 11^WWell No. 1- NorrisArch Merriman Company

FIRST REPORT _____ Contractor

SECTION PLAT

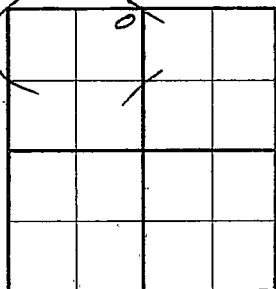

Special

330 Ft. from N Line

_____ Ft. from S. Line

330 Ft. from E. Line

_____ Ft. from W. Line

Location ✓

Rig up _____

Drilling and Remarks:

RECORD

Cased _____ in., _____ ft.

Sand _____

Gas _____

Oil _____

Total Depth _____

PRODUCTION

1st 24 hrs. Nat. //1st 24 hrs. after shot //

Gas _____ Cu. Ft.

Dry Hole _____

Abandoned _____

Date

SEP 15 1937 19

H. D. Hatfield Scout

Barton **KANSAS**Map No. 53 Sec. 33 Twp. 17 R. 11Well No. 1 NorrisArch Merriam

Compan

Contractor

ABANDONED**NE NW**330 Ft. from N. Line Ft. from S. Line330 Ft. from E. Line Ft. from W. Line**SECTION PLAT**

		0		

RECORDLocation Cased 6 in., 3234 ft.Rig up Sand 51 3345

Drilling and Remarks:

Gas Oil Total Depth 3354**PRODUCTION**1st 24 hrs. Nat. 1st 24 hrs. after shot Gas Cu. Ft.Dry Hole Abandoned

Date

DEC 1 - 1937

19

H. D. Hatfield Scout

H. F. W.

DVA