

**KANSAS**

FORM 51 5M 1-42 PETROL

**KANSAS**

Cowley

Section 26 Township 30 Range 4E

Well No. # 4 Hanlen


Company Aylward Production

Miscellaneous

NORTH

WEST

EAST

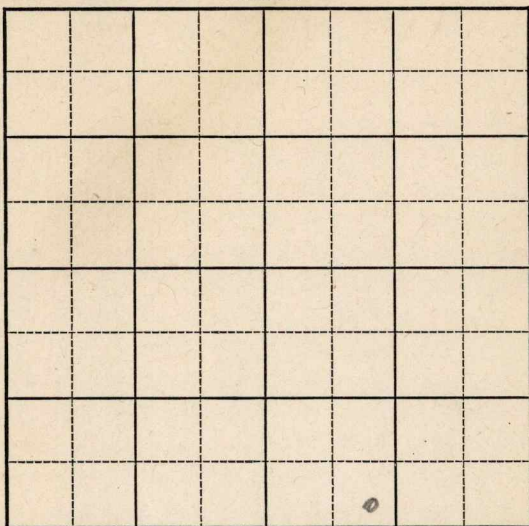

SOUTH

Sec. 26 Twp. 30 R. 4E

Well No. 4 Hanlen Farm

Aylward Production

Company


(Miscellaneous)

           Ft. from N. Line

330 Ft. from S. Line

           Ft. from E. Line

330 Ft. from W. Line

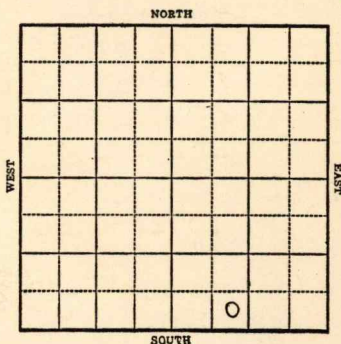

1942

R E P O R T

|       |                     |
|-------|---------------------|
| 10/28 | Cable               |
| 11/4  | "                   |
| 11/11 | "                   |
| 11/18 | "                   |
| 11/24 | "                   |
| 12/2  | "                   |
| 12/9  | SD for crew         |
| 12/16 | " "                 |
| 12/22 | " "                 |
| 12/29 | " "                 |
| 1943  |                     |
| 1/6   | " "                 |
| 1/13  | Spud                |
| 1/20  | 15" Casing set 190' |
|       | 12" Casing set 669' |
|       | Drlg. 752'.         |
| 1/27  | 1410' Run. 10"      |
| 2/3   | 10" @ 1690'         |
|       | TD 1755'            |
|       | WR 10"              |

**OVER**

1943

2/10 10" Casing set 1763  
Drlg. 2210'

2/17 **K.C. 2330**  
8" Casing set 2185  
6" Casing set 2500  
Drlg. 2530'

2/24 **Bart 2950**  
TD 2964 SO  
5" Casing set 2946 WOC.

3/3 TD 2967-400' oil 10 qts 2950-60  
C.O.

3/10 40 qts 2950-60 CO

3/17 **Bart 2950**  
5" @ 2946'  
T.D. 2967'  
10 qts. 2950-60  
40 qts. 2950-60  
Swab 27 bbls oil Pot.  
Gravity 36.8

**COMPLETED**

Map No. 11 Sec. 26 Twp. 30 R. 4EWell No. 4 HanlenAylward Production

Company

FIRST REPORT

Contractor

SE SW SE

       Ft. from N. Line330

Ft. from S. Line

       Ft. from E. Line990

Ft. from W. Line

## SECTION PLAT

|  |  |  |  |
|--|--|--|--|
|  |  |  |  |
|  |  |  |  |
|  |  |  |  |
|  |  |  |  |

## MISCELLANEOUS

Location                     Rig up                     

Drilling and Remarks:

Cable

## RECORD

Cased            in.,            ft.Sand                     Gas                     Oil                     Total Depth                     

## PRODUCTION

1st 24 hrs. Nat.                     1st 24 hrs. after shot                     Gas                      Cu. Ft.Dry Hole                     Abandoned                     

Date

OCT 28 1942 19S. J. LEWIS

Scout

KANSAS


Map No. 11 Sec. 26 Twp. 30 R. 4EWell No. 4 HanlenAylward Production Company

COMPLETED

Contractor

SE SW SE

## SECTION PLAT

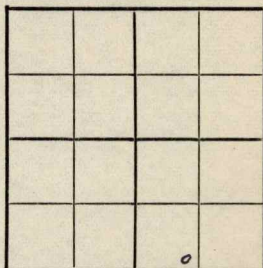       Ft. from N. Line330 Ft. from S. Line       Ft. from E. Line990 Ft. from W. Line

## MISCELLANEOUS

Location                                 Rig up                                 

Drilling and Remarks:

*Bar & 2950**5' @ 2946**10' to 2950-60**40 " 2950-60**sw & 27 oil P.O.**36 8 1/2*

## RECORD

Cased            in.,            ft.Sand                                 Gas                                 Oil                                 Total Depth 2967

## PRODUCTION

1st 24 hrs. Nat.                                 1st 24 hrs. after shot                                 Gas                                  Cu. Ft.Dry Hole                                 Abandoned                                 

Date

MAR 17 1943

19

S. J. LEWIS Scout