

Barton

KANSAS

35

17


11W

SECTION _____ TOWNSHIP _____ RANGE _____

WELL NO. #1 Evans

COMPANY Bennett & Roberts

NORTH

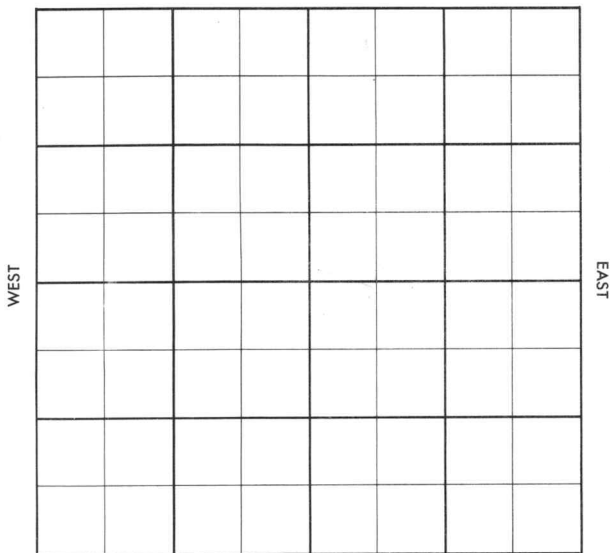

SOUTH

Barton

KANSAS

SEC. 35	TWP. 17	R. 11W
------------	------------	-----------

WELL NO. #1 Evans FARM

COMPANY Bennett & Roberts

CONTRACTOR Co. Tools


NW Claflin

_____ Ft. from N. Line

_____ Ft. from S. Line

_____ Ft. from E. Line

_____ Ft. from W. Line

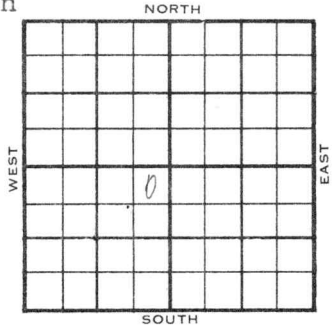

NE NE SW

1956	ELEVATION 1826 DF	REPORT
------	----------------------	--------

4-18 Comm. 4-14-56
8" @ 222 w/135
Drlg. 1515

4-25 DST 3029-63 op 40 min. rec. 36' mud,
BHP 240/20"
DST 3093-3105 op 1 hr. rec. 52' MSW,
BHP 530/20"
D & A
Tp. 2643
H. 2897
Tr. 2921
BL 3010
L. 3025
C. 3309
Rework 3345
TD 3378'

ABANDONED

County Barton Elev. _____
 Sec. 35 Twp. 17 Rge. 11W
 Company Bennett & Roberts
 Farm Name Evans No. 1

TOPS	DEPTH	LOG	DATUM
Anh.			
Tp.			
H.			
Tr.			
Dg.			
Bl.			
L.			
K.C.			
B.K.C.			
Ce.			
C.			
M.			
M.			
K.			
Mz.			
Me.			
V.			
S.			
S.			
A.			
R.			
Pe.			
G.			
T.D.			

Loc. in Sec. NE NE SW
 Geol. _____
 Contr. _____
 Go! tools
 Pool Bloomer
NW Claflin

FIRST REPORT
 APR 18 '56

Date Comm. 4-14-56
8" @222/135 drlg. 1515

APR 5 4 1956
 R.G.

Co.
 Use.
 No.
 Sec.
 T.
 R.

County Barton Elev. 1826 DF
 Sec. 35 Twp. 17 Rge. 11W
 Company Bennett & Roberts
 Farm Name Evans No. 1

TOPS	DEPTH	LOG	DATUM	Loc. in Sec.
Anh.				NE NE SW
Tp.	2643			
H.	2897			
Tr.	2921			
Dg.				
BL.	3010		1186	
L.	3025		1199	
K.C.				Geol.
B.K.C.				Contr.
Ce.				Co. tools
C.	3309		1488	Pool <u>Bloomer</u>
M.				<u>W. Haflin</u>
M.				
K.				
Mz.				
Me.				
V.				
S.				
S.				ABANDONED
A	Rework 3345		1519	
R.				
PE.				
G.				
T.D.	3378			

Date Comm. 4-14-56 APR 25 1956

8" 0222/235 cor. 1515 APR 25 1956 DST
 3029-63 40" rec 36' Md BHP
 240/20 DST 3093-3105 1hr
 rec 52' MSW BHP 530/20

DEA