

Barton

KANSAS
11W

Section 35 Township 17 Range 11W


Well No. 1 Moser

Company Atlantic Ref.

NORTH

WEST

EAST

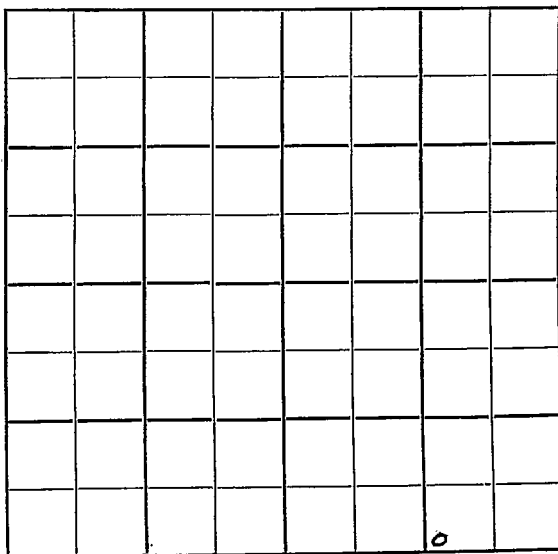


SOUTH

Barton KANSAS ✓

Sec. 35 Twp. 17 R. 11 WWell No. # 1 Moser SWD FarmAtlantic Ref. CompanyHonaker Drlg. ContractorBloomer Pool Ft. from N. Line330 Ft. from S. Line1100 Ft. from E. Line Ft. from W. Line

SW SW SE SE

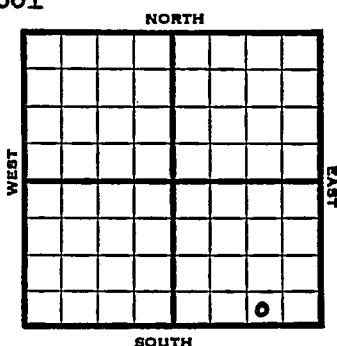

1952 Elev. 1797' REPORT

12/17 Spud 12-15-52
 10" @ 232
 Drlg. 355'

12/25 " "

1/1 Heeb 2878 Br1-2992 Lans 3006 Cong
 3287 Arb 3322 RTD 3420 7" @ 3420

1/8 CO 3420 FU 2000' wtr DD 3494
 Tools Stuck

1/22 Reagan 3555' DD 3594'

1/28 Spud 12-15-52

SWD Well

Td 3594

10" @ 232

Heeb 2878, Br lime 2992, Lans
 3006, Cong 3287 1/2 Arb. 3322,

TD 3420

7" @ 3420

CO to 3420

FU 2000' wtr.

DD 3494

Regan 3555

DD 3594 500A

Abd. for SWD Well

ABANDONED

County Barton State Kansas

Sec. **35** (Blk. Twp.) **17** (Sur. Rge.) **11W** Map No.

Operator **Atlantic Ref.**

Well No. 7 Farm Moser SWD

Elev.	Location	SW	SW	SE	SE
-------	----------	----	----	----	----

FIRST REPORT

330 Ft. From	S Line	SE
1100 Ft. From	E Line	Quarter

1st. Report DEC 17 1952

Completion


Remarks

Honaker Drlg. - Contr.

Spudding Date **12-15-52.**

Drig. Data Bloomer Pool

10" @ 232 drlg. 355

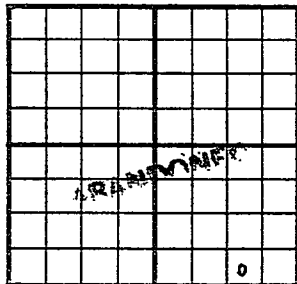County Barton State KansasSec. 35 (Blk.) 17 (Sur.) 11W Map No.Operator Atlantic Ref.Well No. 1 Farm Moser SWDElev. 1797 Location SW SW SE SE330 Ft. From S Line SE1100 Ft. From E Line Quarter1st. ReportCompletion JAN 28 1953Remarks Bloomer PoolHonaker Drlg. - Contr.Spudding Date 12-15-52Drlg. Data SWD well TD 359410" @ 232 Heeb. 2878 Br. lime 2992Lans. 3006 Cong. 3287 Arb. 3322TD 3420 7" @ 3420 CO to 3420FU 2000' wtr. DD 3494 Regan 3555DD 3594 500 A Abd. for SWD well

J. G. McGEHEE