


Section 36 Township 17 Range 11-17

Well Number #2-Bloomer

Company Republic O & Gas

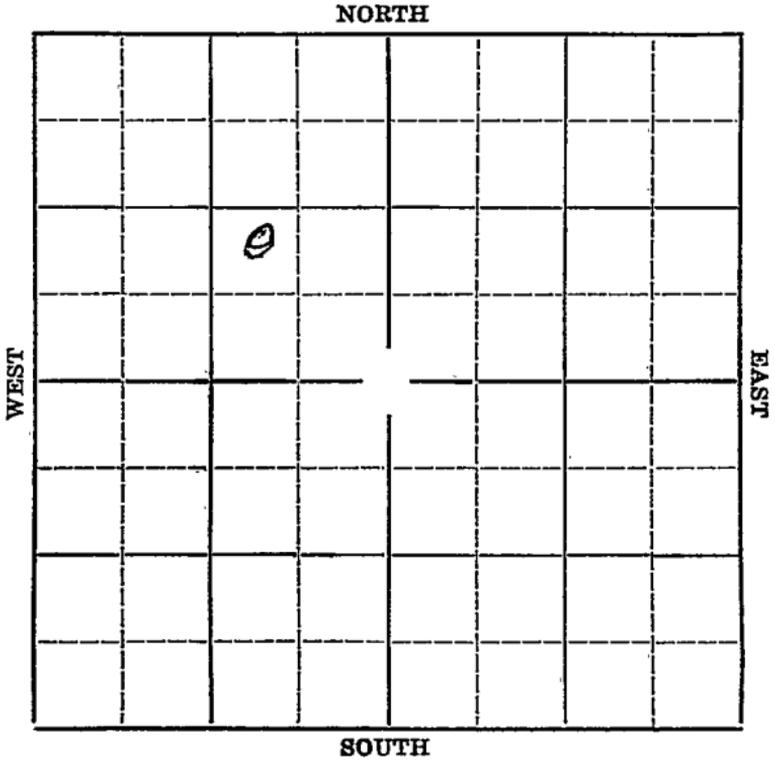


Map No. KANSAS Sec. 36 Twp. 17 R. 11W

Well No. #2 Bloomer Farm

Republic O & Gas. Company

NORTH

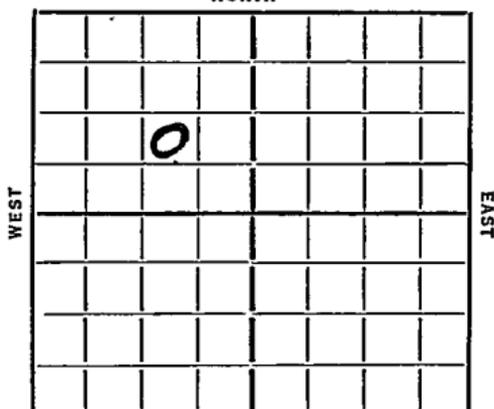

\_\_\_\_\_ Ft. from N. Line

990' Ft. from S. Line

990' Ft. from E. Line

\_\_\_\_\_ Ft. from W. Line

Elev. 1818

SOUTH

Date	REPORT
1936	
8/12	Rig.
8/20	--
8/27	Drlg. 890'.
9/3	Drlg. 2740'.
9/23/36	-Sil. 3276'.
	T.D. 3287'.
	2000 gallons of acid.
	Potential 1136 bbls of oil.
	<b>COMPLETED</b>

Map No. 55 Sec. 36 Twp. 17 R. 11W

Well No. 2 Bloomer

Republic Oil & Gas Company

Contractor

SECTION PLAT

	0		

\_\_\_\_\_ Ft. from N. Line

990 Ft. from S. Line

990 Ft. from E. Line

\_\_\_\_\_ Ft. from W. Line

FIRST REPORT

Location \_\_\_\_\_

Rig up \_\_\_\_\_

Drilling and Remarks:

*Rig*

RECORD

Cased \_\_\_\_\_ in., \_\_\_\_\_ ft.

Sand \_\_\_\_\_

Gas \_\_\_\_\_

Oil \_\_\_\_\_

Total Depth \_\_\_\_\_

PRODUCTION

1st 24 hrs. Nat. \_\_\_\_\_

1st 24 hrs. after shot \_\_\_\_\_

Gas \_\_\_\_\_ Cu. Ft.

Dry Hole \_\_\_\_\_

Abandoned \_\_\_\_\_

Date

AUG 12 1936 19

S. J. LEWIS Scout

Map No. 33 Sec. 36 Twp. 17 R. 11WWell No. 2 BloomerRepublic O & G Company

Contractor

## SECTION PLAT

	0		

\_\_\_\_\_ Ft. from N. Line

990 Ft. from S. Line990 Ft. from E. Line

\_\_\_\_\_ Ft. from W. Line

**COMPLETED**

Location \_\_\_\_\_

Rig up \_\_\_\_\_

Drilling and Remarks:

Oil 3276.2000 acidP 8/136

## RECORD

Cased \_\_\_\_\_ in., \_\_\_\_\_ ft.

Sand \_\_\_\_\_

Gas \_\_\_\_\_

Oil \_\_\_\_\_

Total Depth 3287

## PRODUCTION

1st 24 hrs. Nat. \_\_\_\_\_

1st 24 hrs. after shot \_\_\_\_\_

Gas \_\_\_\_\_ Cu. Ft.

Dry Hole \_\_\_\_\_

Abandoned \_\_\_\_\_

Date

SEP 23 1936S. J. LEWIS Scout